



Memorandum

September 21, 2016

To: Steve Renninger & Leslie Patterson, USEPA;
Madelyn Adams, Ohio EPA

Ref. No.: 038443-201

From: Julian Hayward/Valerie Chan/cb/37

CC: Ken Brown, ITW; Jim Campbell, EMI, Wendell Barner;
Barner Consulting; Bryan Heath, NCR

Subject: Dryden Road Buried Utility Information

United States Environmental Protection Agency (USEPA), GHD, and the Respondents to the Administrative Settlement Agreement Order on Consent for Removal Action Docket No. V-W-13-C-010 (Respondents) participated in conference calls regarding the elevated levels of methane detected seasonally from soil gas probe GP-2. GP-2 is located on the east side of Dryden Road in Moraine, Ohio, adjacent to the Dayton Power and Light property at 1900 Dryden Road, as shown on Figure 1.

GHD notes that the soil gas monitoring at probes in the vicinity of GP-2 on the west side of Dryden Road shows the general absence of methane. The gas present at GP-2 has been confirmed to be a mixture of methane and petroleum-related substances. On this basis a local source in the area of GP-2 appears to be causing the elevated readings at GP-2. Information regarding buried utilities has been collected to examine the possibility of preferential gas migration pathways as outlined in this memo.

Based on the conference call discussions, GHD completed the following:

- Provided notification of the potential explosive hazard to Dayton Power and Light (DP&L) and the City of Moraine, on August 16, 2016.
- Contacted the City of Moraine to request information regarding buried utilities, and was directed to Ohio Utilities Protection Services (OUPS), on August 24, 2016.
- Contacted OUPS on August 24, 2016. OUPS issued Ticket A623702683-00A on the same date.
- Completed sampling from and third-party laboratory analysis of GP-2 soil gas for TO-15 and methane, the results of which were provided to DP&L and City of Moraine on September 9, 2016.

OUPS member Montgomery County provided copies of various drawings (Attachment 1) with information on the following utility types, sanitary sewer, water mains, and natural gas lines. Underground utility information from remaining OUPS members (AT&T, Cincinnati Bell, Centurylink, Level 3 Communication, etc.) is presented in Attachment 2. The information from OUPS did not provide specific details for storm sewers. GHD contacted Miami Conservancy District, Montgomery County, and the City of Moraine to request said information but none was available. GHD made observations of storm drains and other features during a site visit on September 14, 2016 in conjunction with weekly soil gas monitoring.




Based on the OUPS documents, GHD and Respondents understand the locations of buried utilities are as follows:

- On the west side of Dryden Road (i.e., adjacent to the South Dayton Dump and Landfill Site [Site]), buried utilities include an 8" or 10" water main, 4" gas line, and 10" sanitary sewer.
- An underground duct (Ohio Bell Telephone) is located slightly west of the centerline of Dryden Road (also known as Springboro Pike).
- There is one buried utility shown on the drawings which crosses over Dryden Road, which is a 6" Gas line that is located slightly south of the south end bridge (i.e., from the Valley Asphalt property) which connects to a 12" gas line on the DP&L property.
- With the exception of Cincinnati Bell, no underground utilities are shown on the east side of Dryden Road, adjacent to the DP&L property, north from East River Road until the 12" gas line described above.

As noted above, the drawings provided by OUPS do not provide storm sewer details. Some of the drawings make limited references to storm sewer piping. GHD conducted an inspection on September 14, 2016, and noted the presence of storm inlets and other features - see Figure 2. The manhole shown in the area of GP-2 is believed to be associated with Cincinnati Bell.

Soil stratigraphy in the area along the west side of Dryden Road is provided by borehole information logged by GHD (formerly Conestoga-Rovers & Associates, CRA). Borehole locations and stratigraphy logs are presented in Attachment 3. Stratigraphy logs for the soil gas probes (GP-1 to GP-7) installed along Dryden Road by USEPA contractor Weston / Dynamac are not available. GP-2 is screened at two depths, 12 and 16 feet below ground surface (ft bgs). In Site area soil gas probes, that interval is characterized by permeable, loose, medium to coarse sand and/or gravel.

The buried utility information for Dryden Road, spanning north from East River Road to Nicolas Road in Moraine Ohio, is presented in the following attachments. The locations of the buried utilities have been summarized above. Based on available information the apparent storm sewer inlets along Dryden Road require further assessment to determine possible interconnection. Otherwise the available information does not indicate the presence of buried utilities crossing Dryden Road that would represent plausible gas migration pathways. Should you have any questions or comments, feel free to contact us.

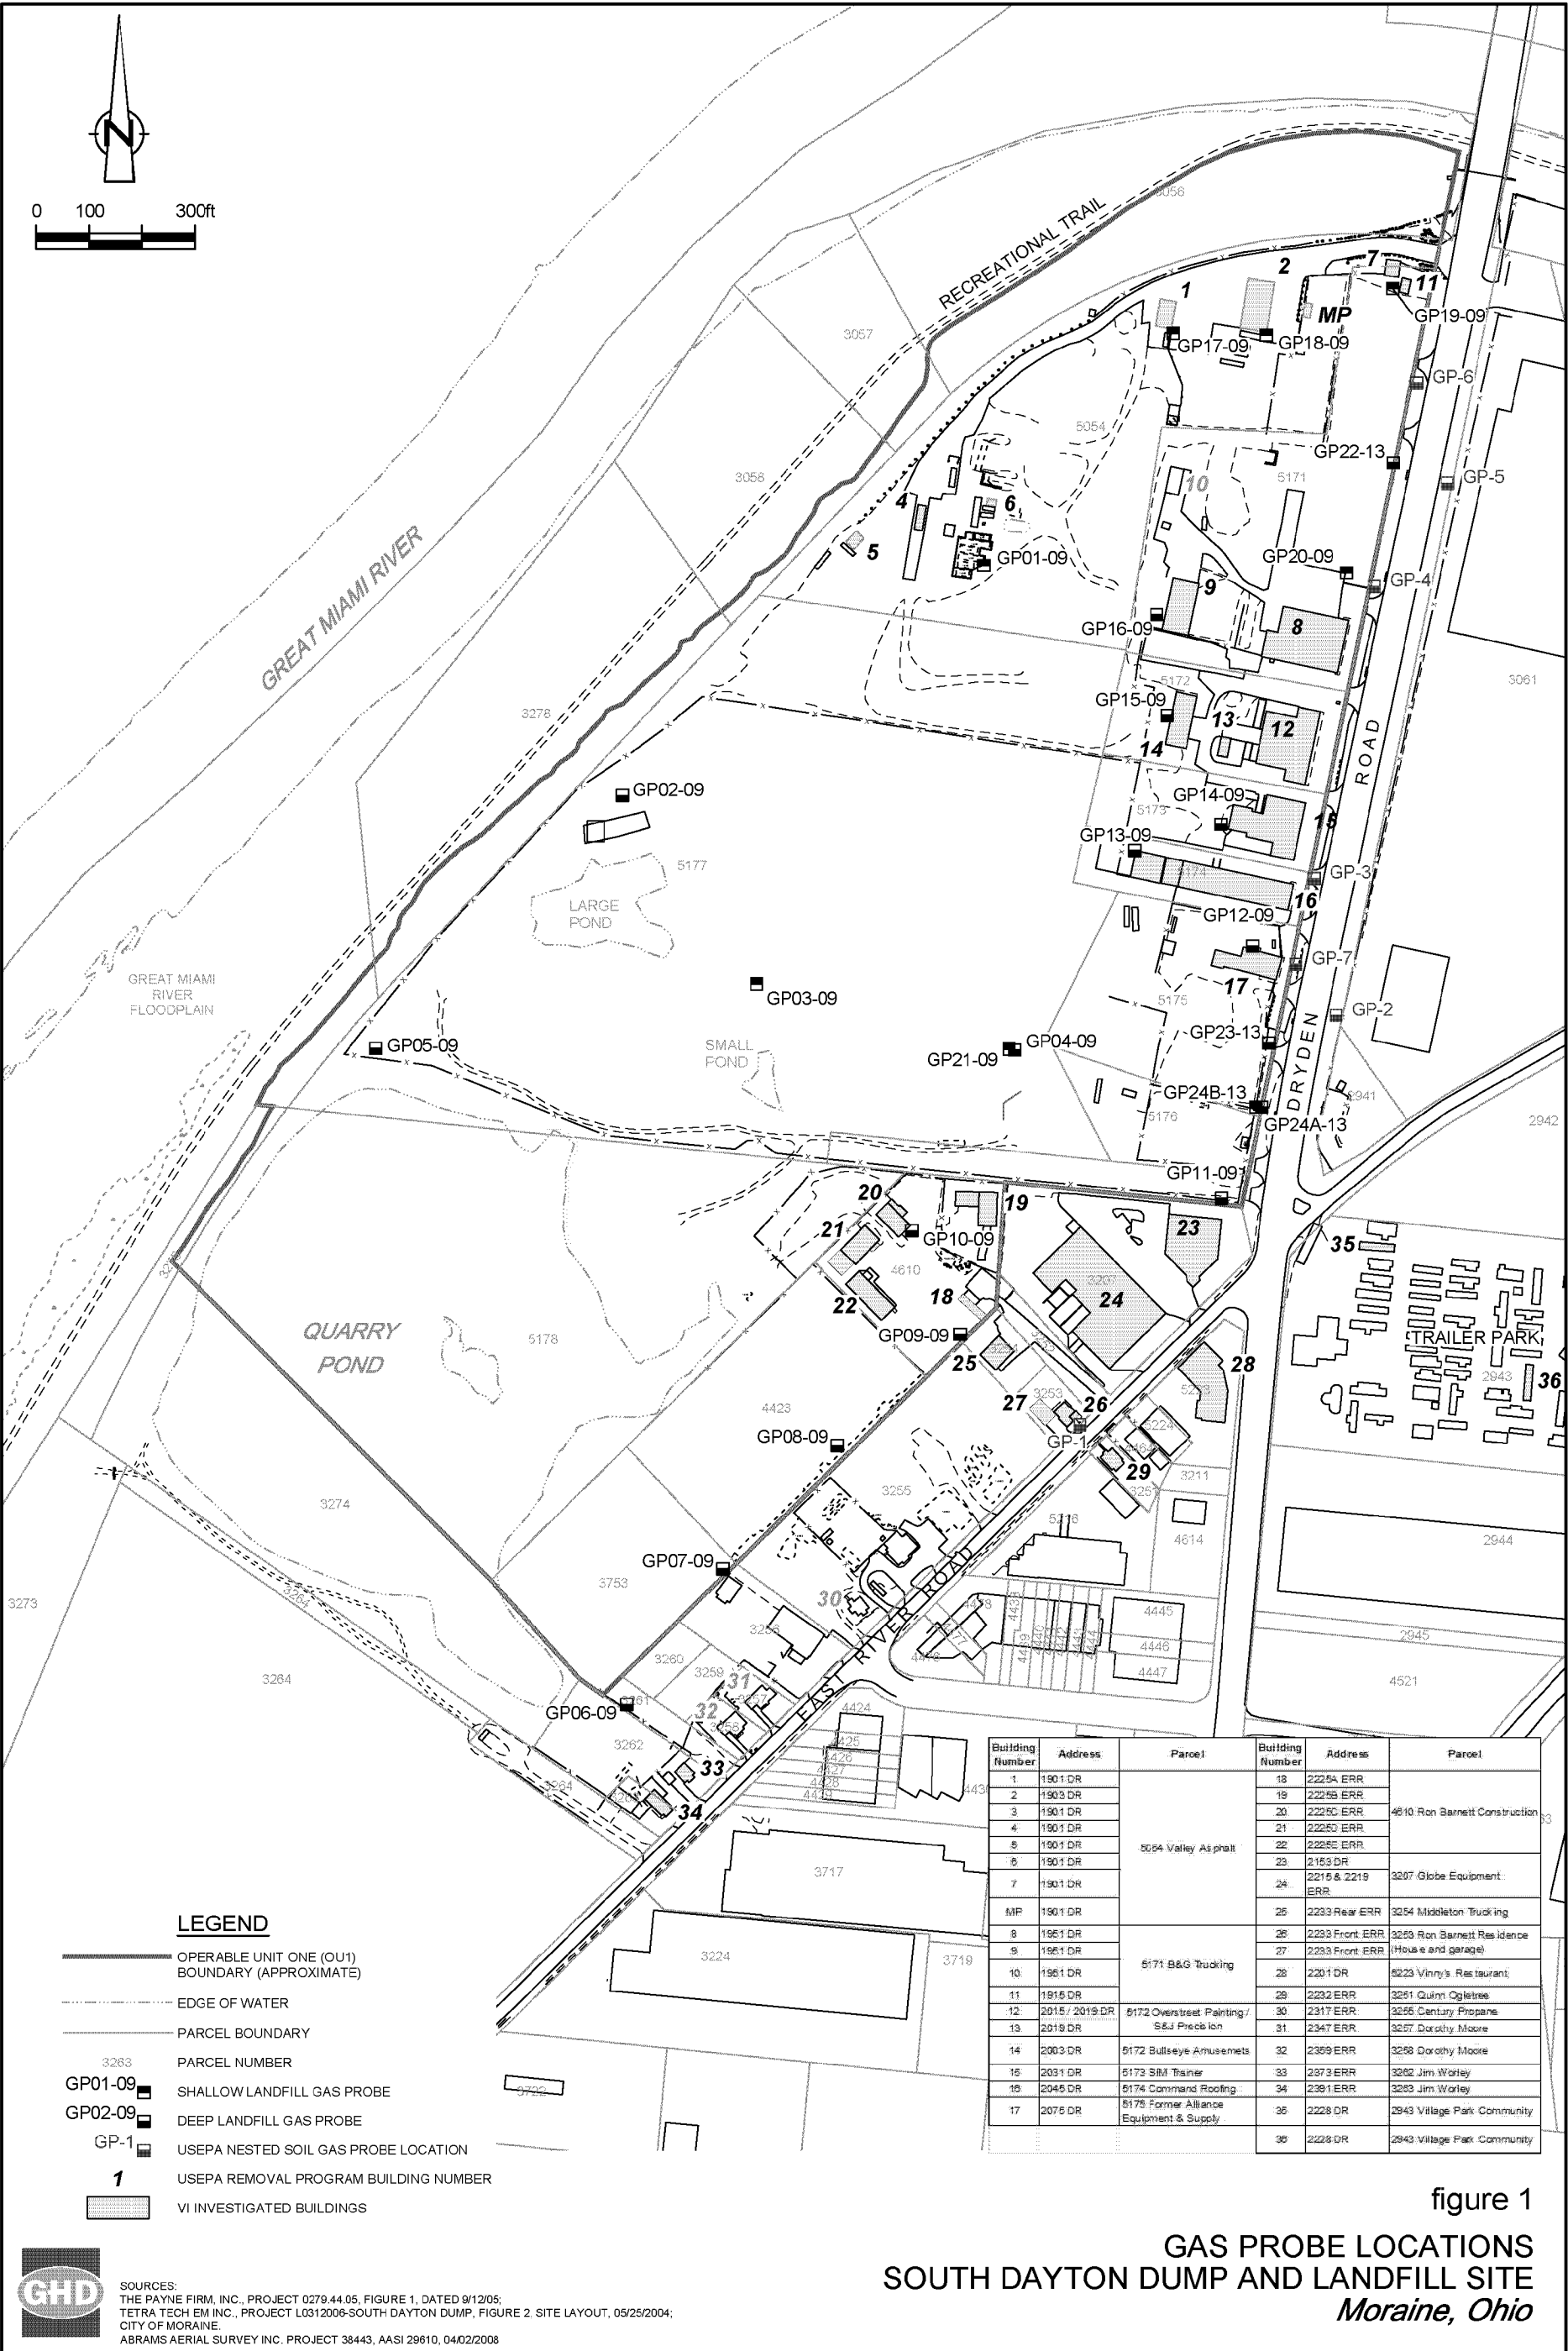

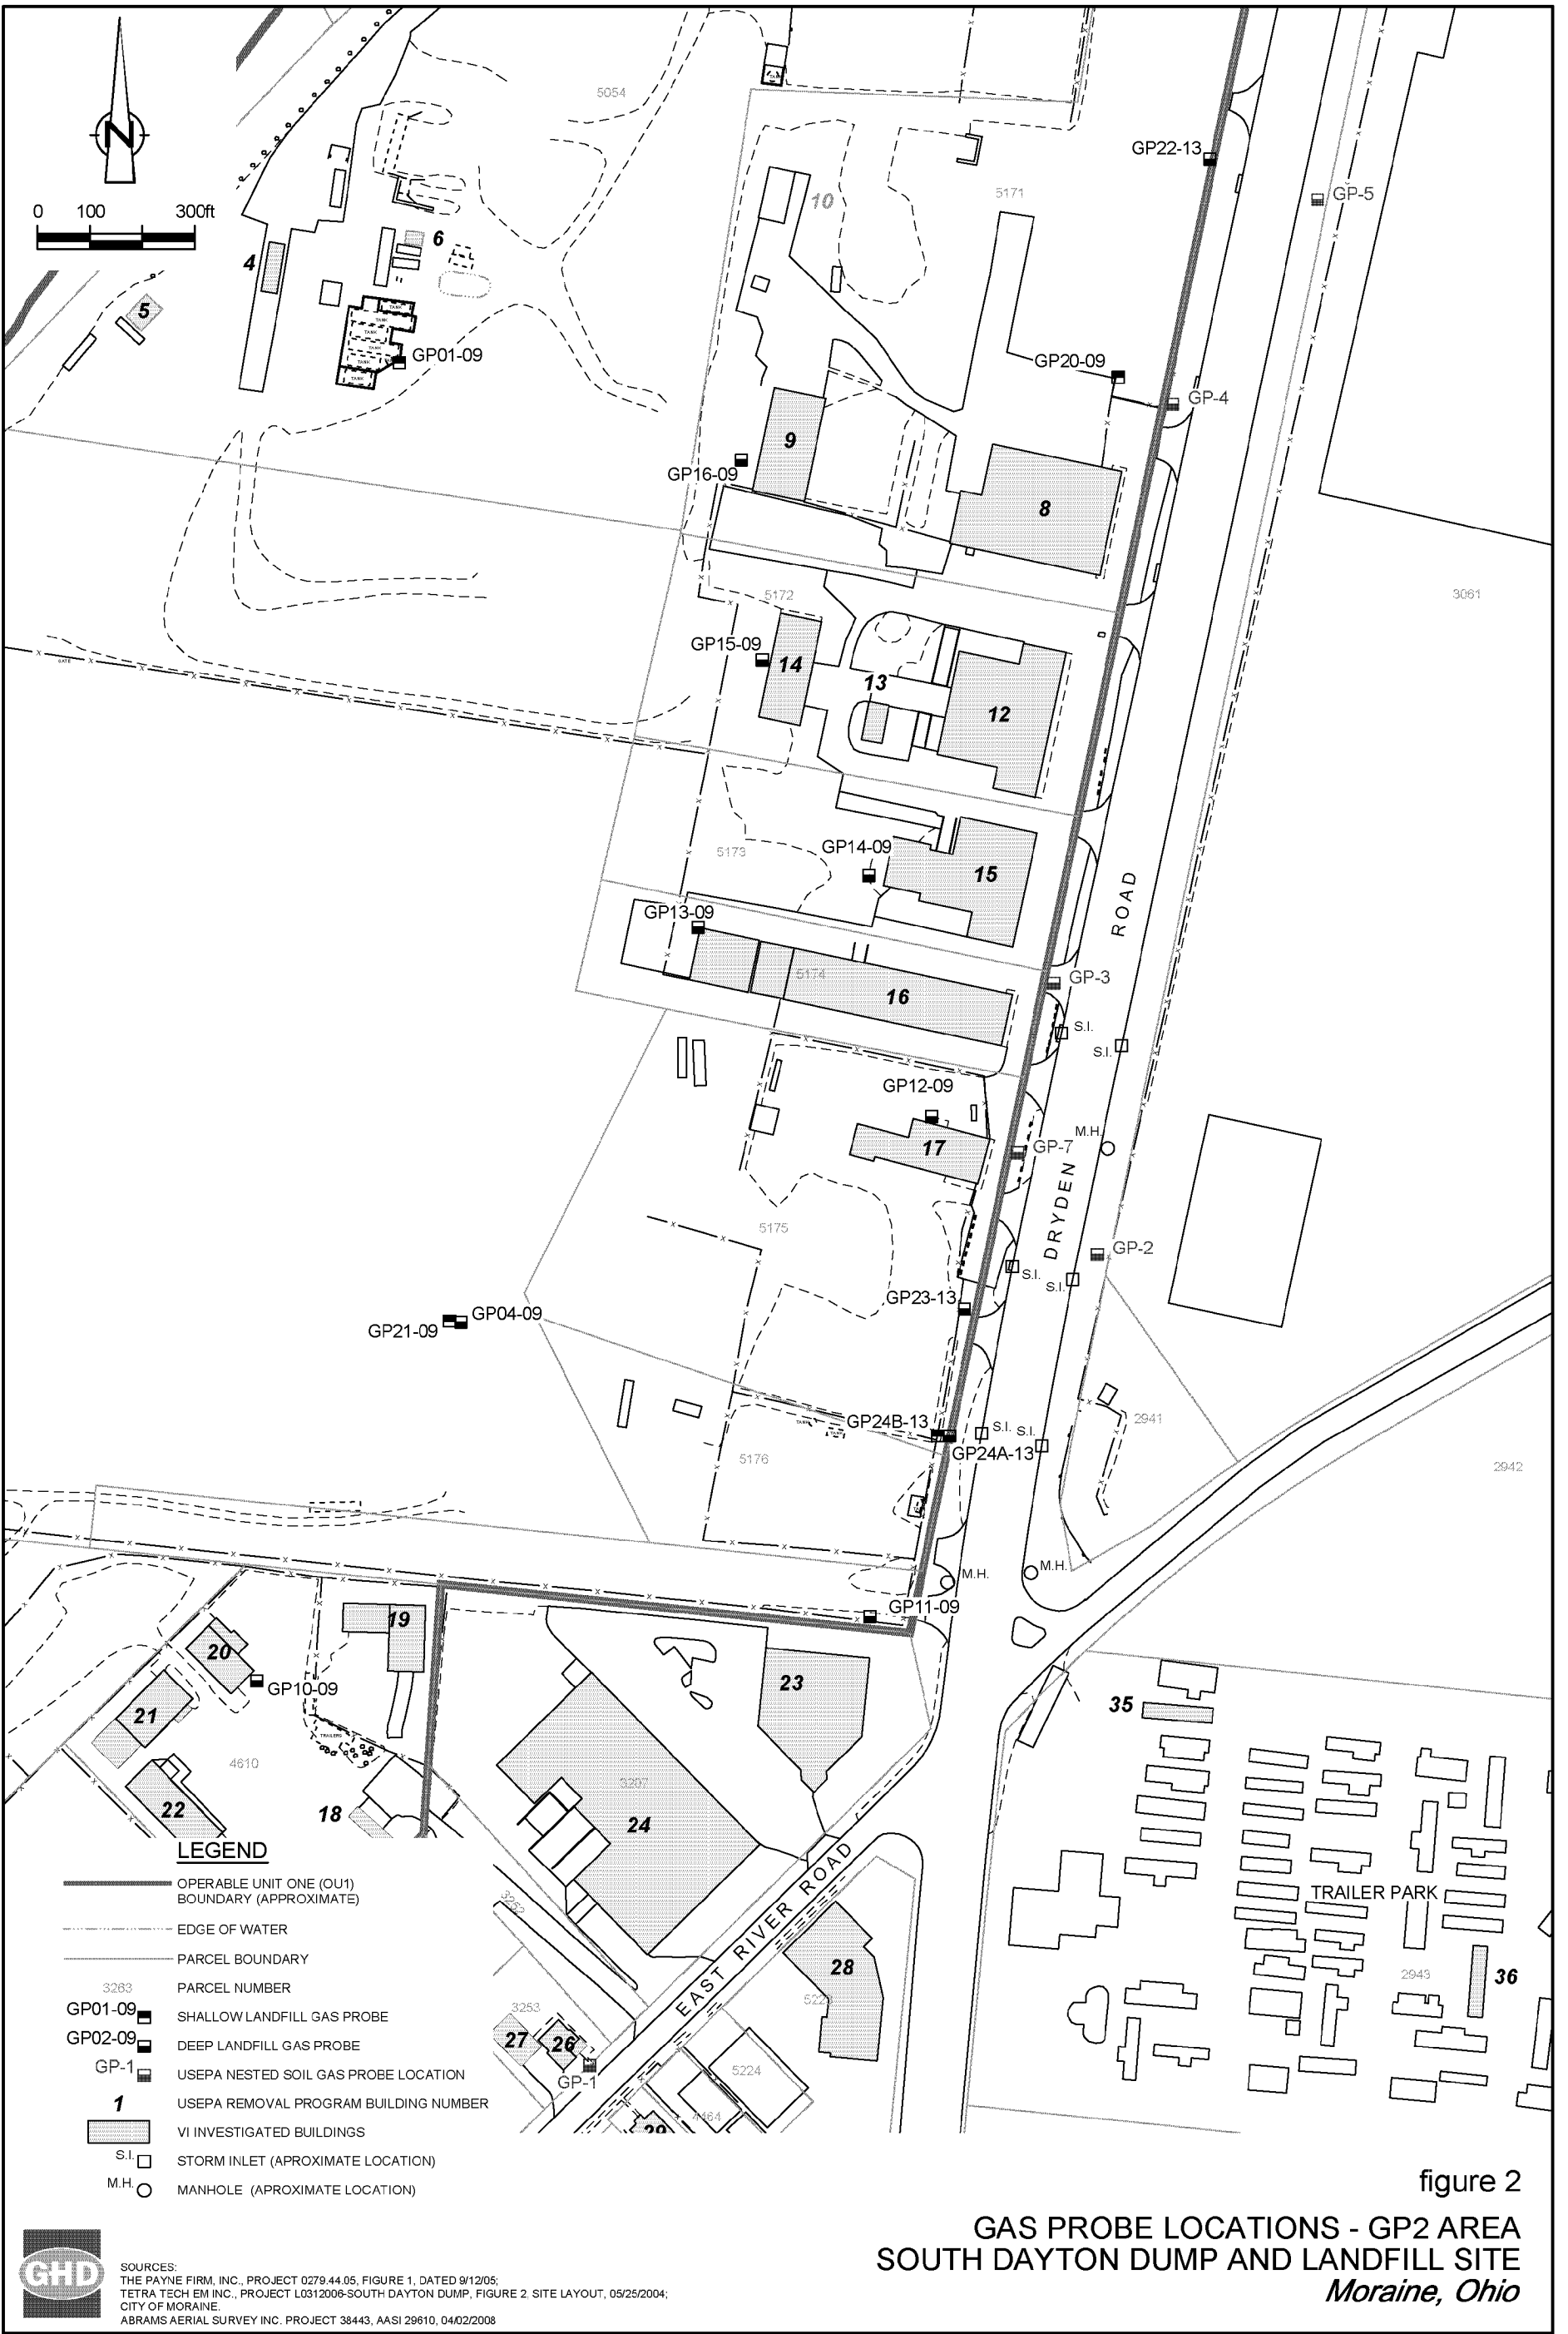



figure 2
GAS PROBE LOCATIONS - GP2 AREA
SOUTH DAYTON DUMP AND LANDFILL SITE
Moraine, Ohio



Attachment 1

[illegible]

63-1517

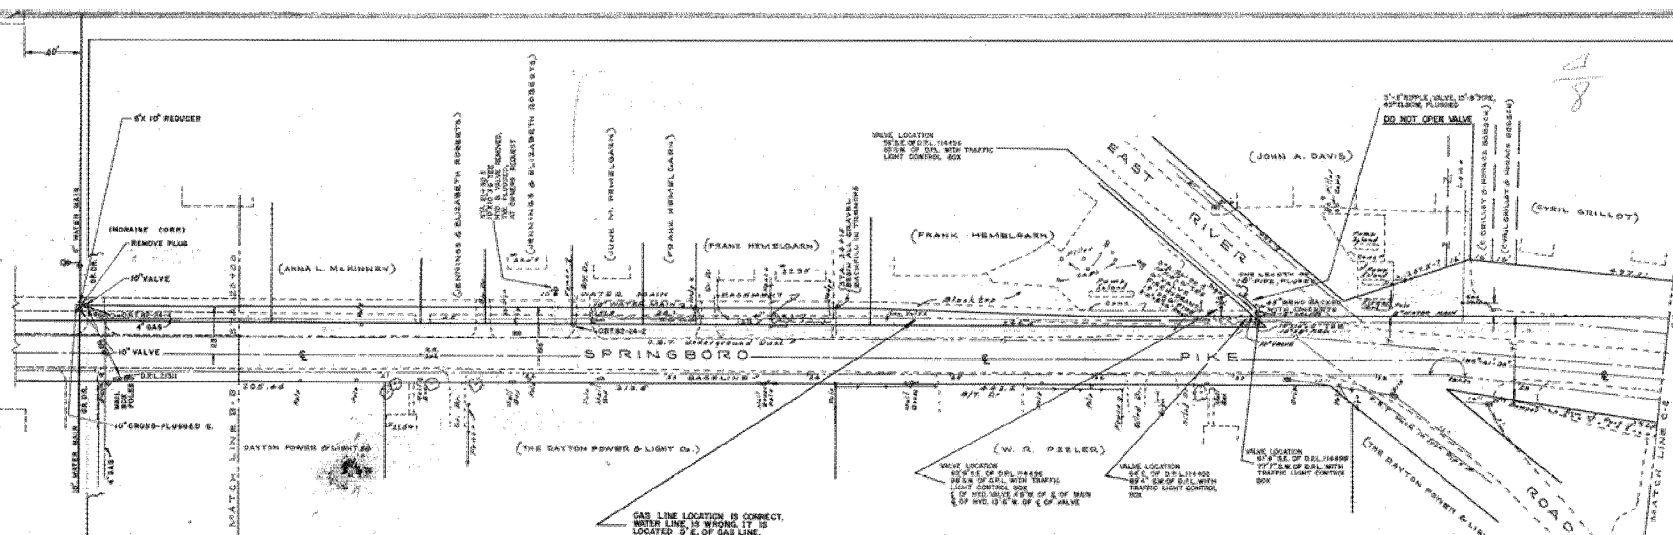


APPROVED BY BOARD
OF COUNTY
COMMISSIONERS

CLERK: James Lee
L. A. Huggins
COUNTY SANITARY ENGINEER

DATE 2-14-61
DATE 2-14-61

WATER LINE NOT TO SCALE

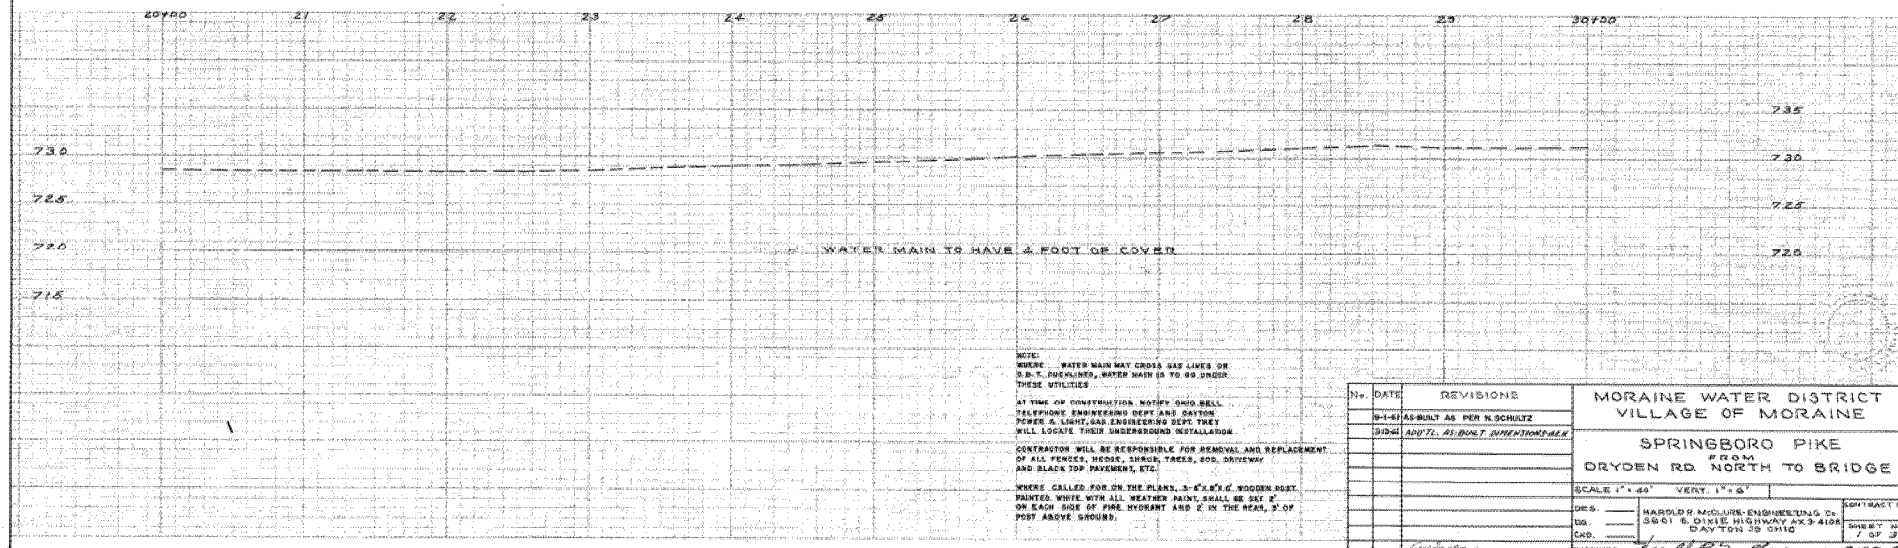

NOTE: WHERE WATER MAIN MAY CROSS GAS LINES OR S.D. T. PUCHLINS, WATER MAIN IS TO GO UNDER THESE UTILITIES.

AT TIME OF CONSTRUCTION NOTIFY OHIO BELL
TELEPHONE ENGINEERING DEPT AND DAYTON
POWER & LIGHT, GAS ENGINEERING DEPT THEY
WILL LOCATE THEIR UNDERGROUND INSTALLATIONS

CONTRACTOR WILL BE RESPONSIBLE FOR REMOVAL AND REPLACEMENT
OF ALL FENCES, HEDGES, SHRUB, TREES, SOIL, DRIVEWAY


WHERE CALLED FOR ON THE PLANS, 3" X 2" X 6" WOODEN POSTS PAINTED WHITE WITH ALL WEATHER PAINT SHALL BE SET 2' ON EACH SIDE OF FIRE HYDRANT AND 2' IN THE REAR, 3' ON POST ABOVE GROUND.

| | | | | |
|----------|--------------------------------|-----------|--|--------------|
| No. | DATE | REVISIONE | MORaine WATER DISTRICT VILLAGE OF MORaine | |
| 9-1-81 | AS-BUILT AS PER N.SCHULTZ | | SPRINGBORO PIKE | |
| 10-18-81 | ADD'L. AS-BUILT DIMENSIONS PER | | FROM DROYEN RD. NORTH TO BRIDGE | |
| | | | SCALE: 1" = 40' VERY: 1" = 6' | |
| | | | DRAWN BY: HAROLD MOORE, ENGINEERING CO. | CONTRACT NO. |
| | | | DES. BY: 3060 E. DIXIE HIGHWAY, APT. 3-4108 | SHEET: 22 |
| | | | CHECKED BY: CANTON, OH 44703 | 1 OF 1 |




For Reference
 Plot #
 Drawn #
 Folder #
 Dated: MORRIS
 Area Map No. 157

Sheet No. 639
 1520
 COORDINATE NO.
 639-1517
 FINAL
 COORDINATE
 W 72

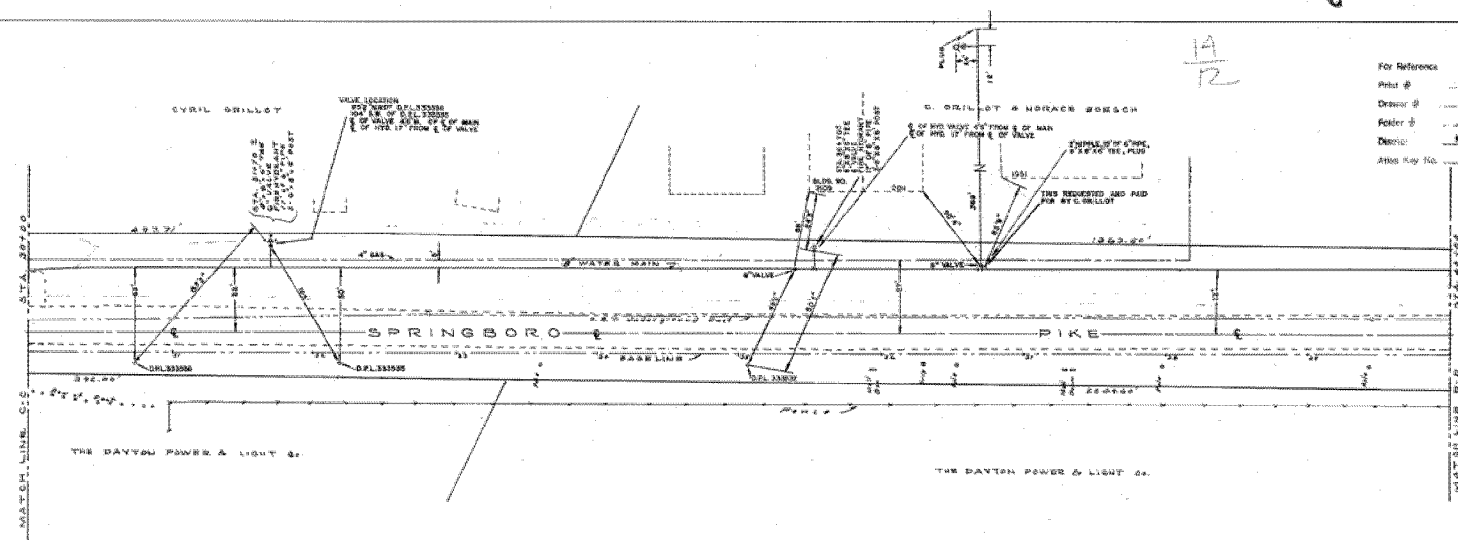


WATER LINE NOT TO SCALE

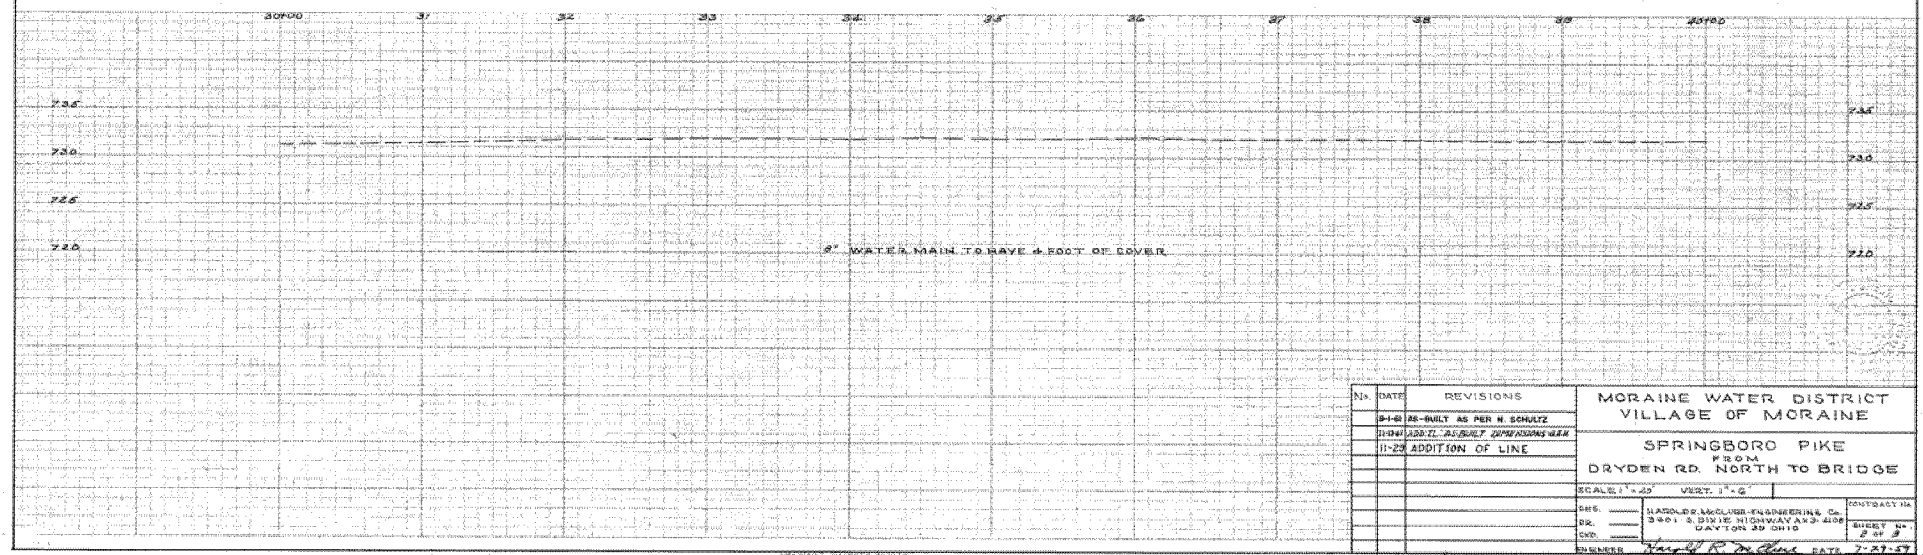

| REVISIONS | | MORRIS WATER DISTRICT VILLAGE OF MORRIS | |
|-----------|----------|--|---------------|
| No. | DATE | | |
| 1-1-21 | 21-21-21 | AS PER H. SCHULTZ | |
| 2-1-21 | 21-21-21 | AS PER H. SCHULTZ | |
| 3-1-21 | 21-21-21 | ADDITION OF LINE | |
| | | SPRINGBORO PIKE FROM DRYDEN RD. NORTH TO BRIDGE | |
| | | SCALE: 1" = 20' | VERT. 1" = 5' |
| | | DESIGNED BY: HATFIELD & MCGILL ENGINEERING CO. 3001 S. DIVISION HIGHWAY A-3, 410E DAYTON, OHIO 45424 | |
| | | DRAWN BY: HATFIELD & MCGILL | DATE: 7-27-21 |

157-011

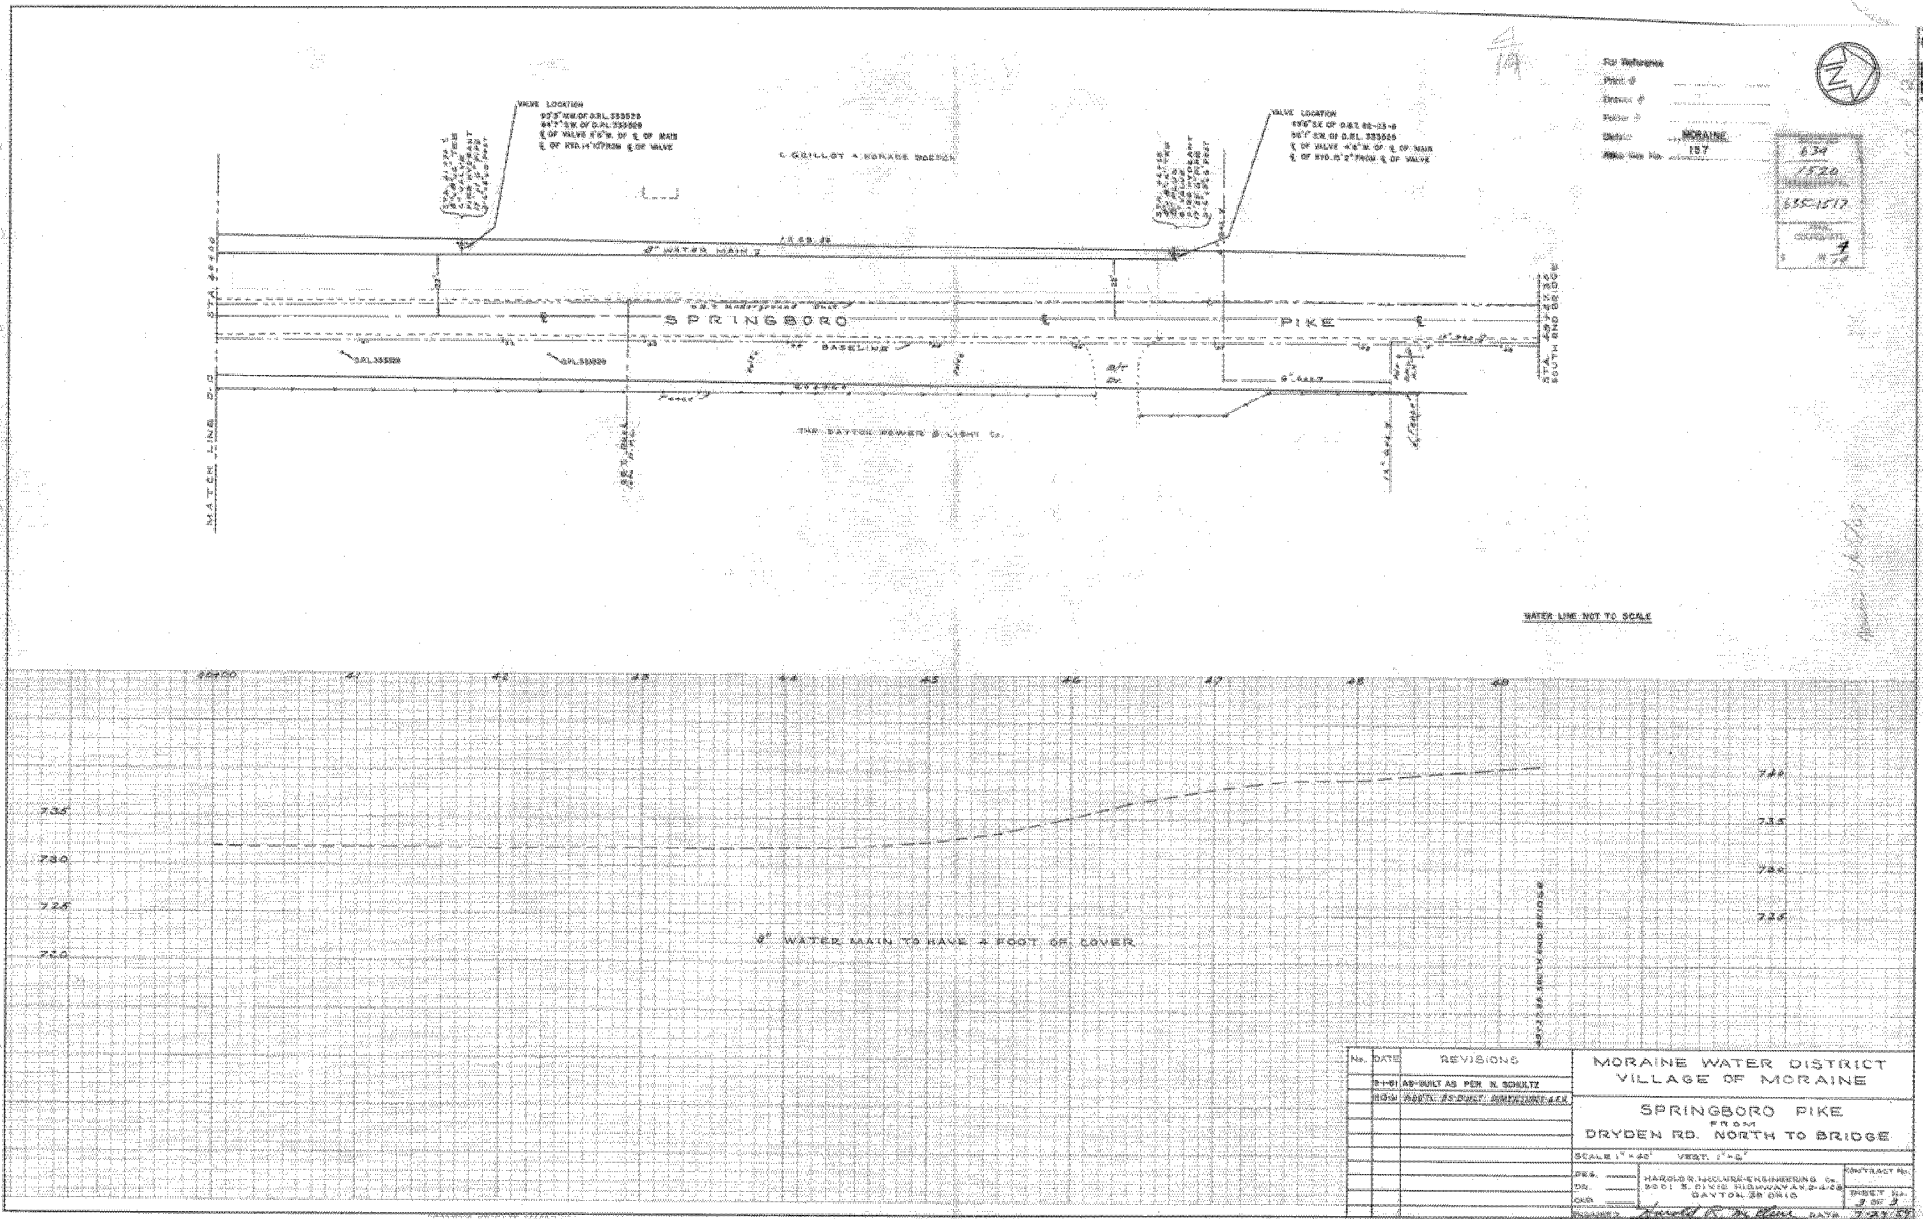



5-2
10

W 2
14


SHEET NO.
634
COORDINATE NO.
635-1517
PANEL
COORDINATE
2
10 W 14




157-014

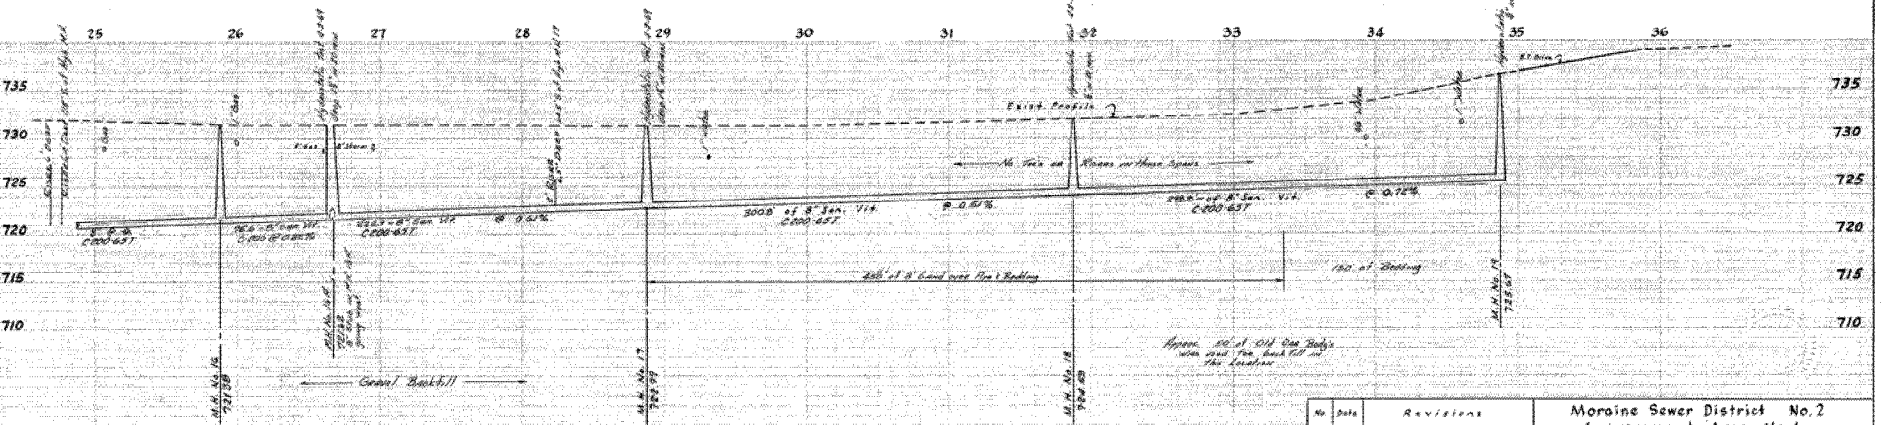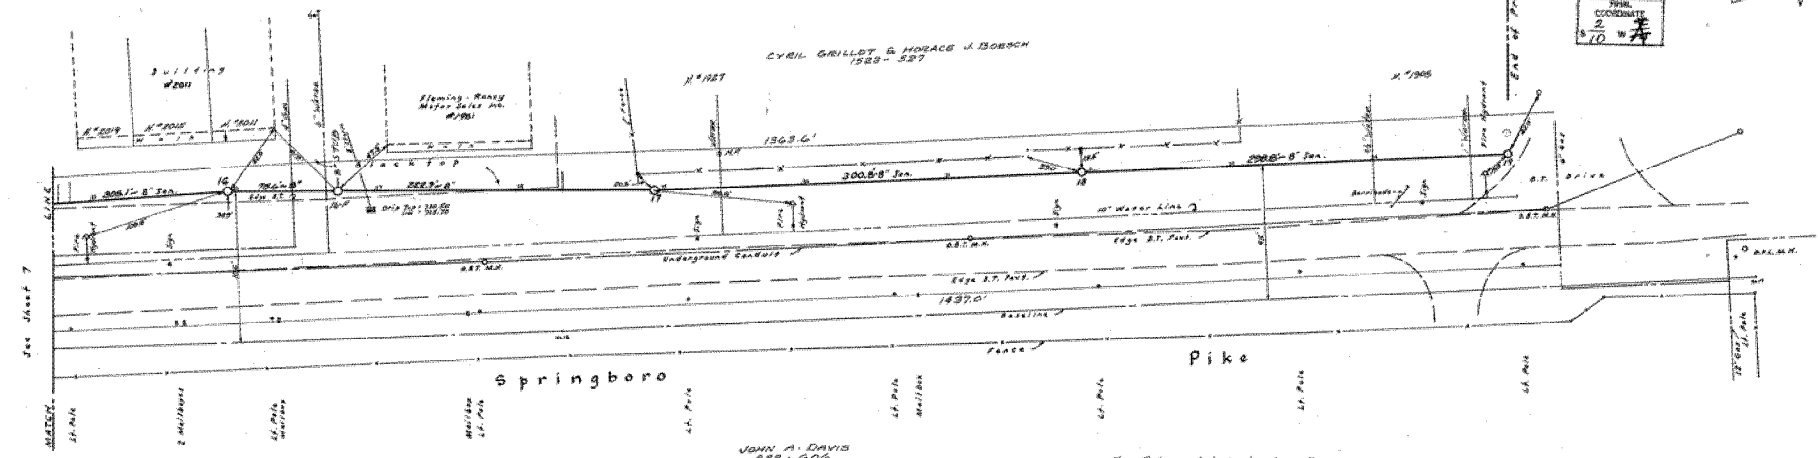


| | | | | |
|----------------------|----------|------------------------|---|---|
| No. | Date | Revisions | Moraine Sewer District No. 2 Improvement Area No. 1 Village of Moraine, Montgomery Co., Ohio Sanitary Sewer Springboro Pike | Sheet No. 8 of 28 Date: 12-1-14 Scale: 1"=50' |
| 1 | 10-26-09 | CHANGED JOINTER BRIDGE | | |
| 2 | 10-26-09 | CHANGED JOINTER BRIDGE | | |
| 3 | 11-11-09 | SEE SCALE | | |
| 4 | 11-11-09 | SEE SCALE | | |
| Bench Mark No. _____ | | | Mt. Clure Engineering Company 3601 South Dixie Hwy. #23-1108 Dayton, Ohio 45439 | Approved by: _____ Date: _____ Drawing No. _____ |
| Approved by: _____ | | | Engineer: <u>Michael E. Padden</u> Date: <u>2-2-15</u> Scale: <u>1"=50'</u> | |

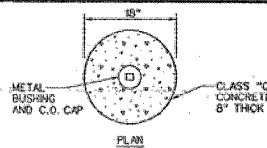


STANDARD CLEAN-OUT DETAIL
N.T.S.

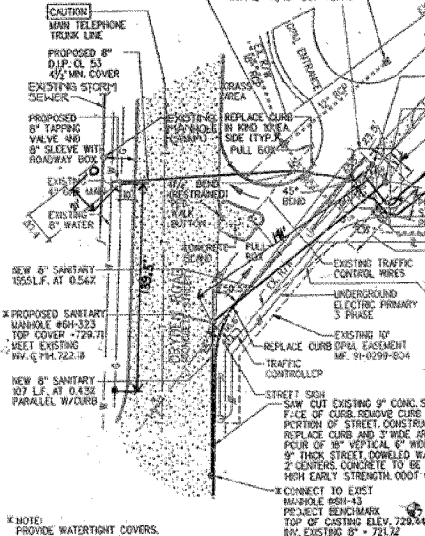

WATER SERVICE TRENCH DETAIL
N.T.S.

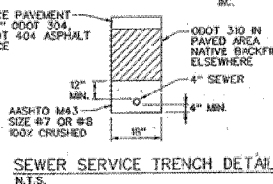

NOTE: FOR PUBLIC MAIN EXTENSIONS THAT ARE OUTSIDE THE STREET, FROM 1' OVER THE THE PIPE ODOT 310 MAY BE USED AS BACKFILL MATERIAL, THEN TOPPED W/NATIVE TOPSOIL.

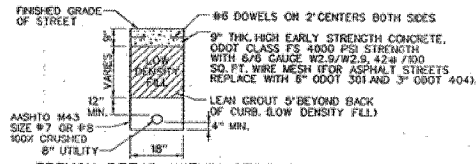


GENERAL NOTES:

1. WHEN CONSTRUCTING SERVICE LATERALS ACROSS DP & L PROPERTY (GRAVEL AREA) THE EXISTING GRAVEL BASE MATERIAL SHALL BE SALVAGED AND RE-USED AT THE COMPLETION OF THE BACKFILLING OPERATIONS.
2. CONTRACTOR TO MAINTAIN TRAFFIC WHILE PERFORMING WORK IN THE R/W PER THE REQUIREMENTS OF CITY OF MORANE.
3. ALL CONCRETE AND EXCESS MATERIAL GENERATED BY THIS PROJECT SHALL BE HAULED OFF SITE AND DISPOSED OF PROPERLY.
4. WHEN CROSSING DRYDEN ROAD IT WILL BE THE RESPONSIBILITY OF THE CONTRACTOR TO REMOVE THE EXISTING CONCRETE TO THE NEAREST CONTROL JOINT AND BY PLATING, DIVERSION AND FLAGMEN TRAFFIC MUST BE MAINTAINED.
5. ALL STREETS, CURBS, TRAFFIC CONTROL DEVICES ETC. ARE THE SOLE PROPERTY OF THE CITY OF MORANE.
6. IF ASSISTANCE IN HOLDING UTILITY POLES DURING SANITARY SEWER INSTALLATION IS REQUIRED, CONTACT DP & L CO. PERSONNEL AT SOUTH YARD.
7. ALL PAVED AREAS TO BE SAW CUT PRIOR TO REMOVAL.
8. SANITARY SEWER LATERAL TO BE TESTED AT 5 P.S.I. OR TEN FEET OF HEAD PRIOR TO FINAL CONNECTION.

SHEET NO. 634/520
COORDINATE NO. 633/517
DATE 8/12/12



BENCHMARK: TOP OF CASTING OF SANITARY MANHOLE ELEVATION = 729.44

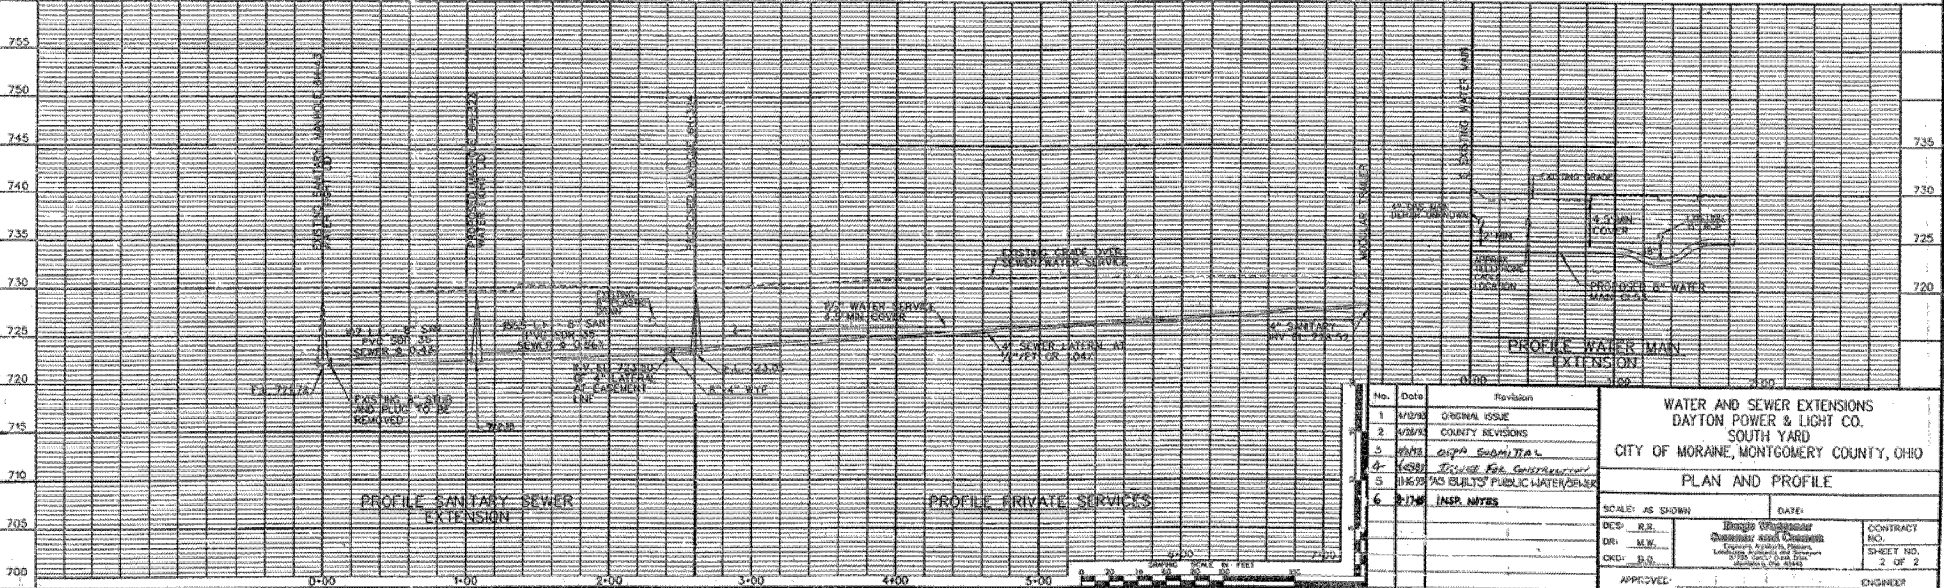

| No. | Date | Revision |
|-----|----------|-------------------------------|
| 1 | 10/10/10 | ORIGINAL ISSUE |
| 2 | 11/10/10 | COUNTY REVISIONS |
| 3 | 11/10/10 | ADDITIONAL SUBMITTALS |
| 4 | 11/10/10 | REVISION FOR CONSTRUCTION |
| 5 | 11/10/10 | AS BUILT'S PUBLIC WATER/SEWER |
| 6 | 8/12/12 | INSPECTION NOTES |

WATER AND SEWER EXTENSIONS
DAYTON POWER & LIGHT CO.
SOUTH YARD
CITY OF MORANE, MONTGOMERY COUNTY, OHIO

PLAN AND PROFILE

SCALE: AS SHOWN

DATE: 8/12/12

DESIGNED BY: [Signature]

DRAWN BY: [Signature]

CHECKED BY: [Signature]

APPROVED BY: [Signature]

CONTRACT NO. [Blank]

SHEET NO. 2 OF 2



ENGINEER [Signature]

SHEET NO.
634
1520


COORDINATE NO.
15
15/17

FINAL
COORDINATE
15
W

157-016

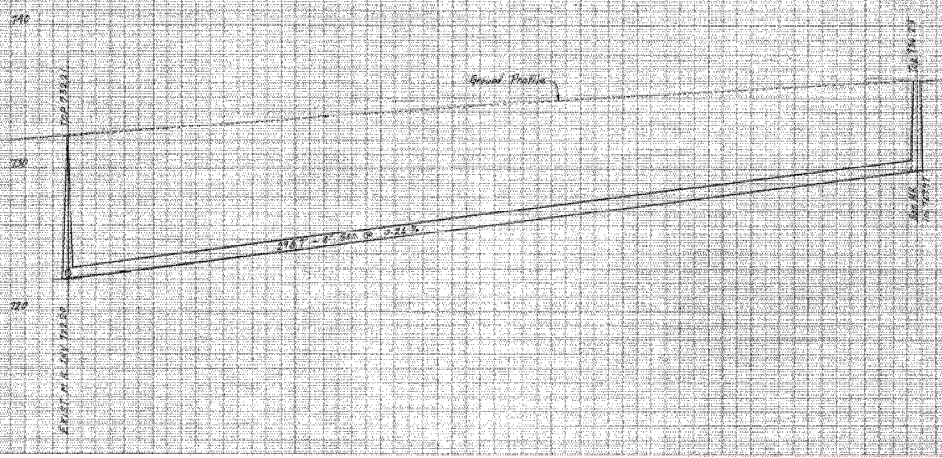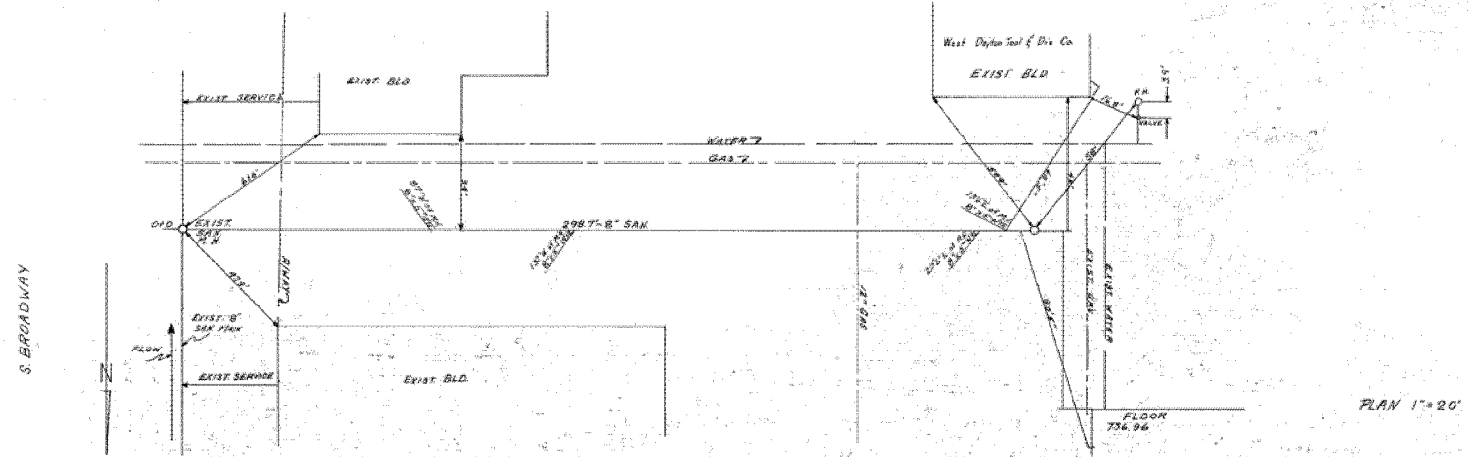

| GREATER MORaine SEWER DISTRICT | | | |
|----------------------------------|------------------|---------------------------------|---------------|
| NO. DATE | REVISION | CITY OF MORaine, MONTC CO. OHIO | |
| 1 | 2000 SAK ASBUILT | PLAN & PROFILE | |
| 2 | 2000 SAK ASBUILT | SEWER ON SOUTH BROADWAY | |
| SCALE: HORIZ. 1"=20' VERT. 1"=4' | | DATE: 8/20/00 | SUBMITTAL NO. |
| DES. J.E. | | J.E. FINFROCK, ENG. | 1 OF 2 |
| CHKD. J.E. | | APPROVED | ENGINEER |

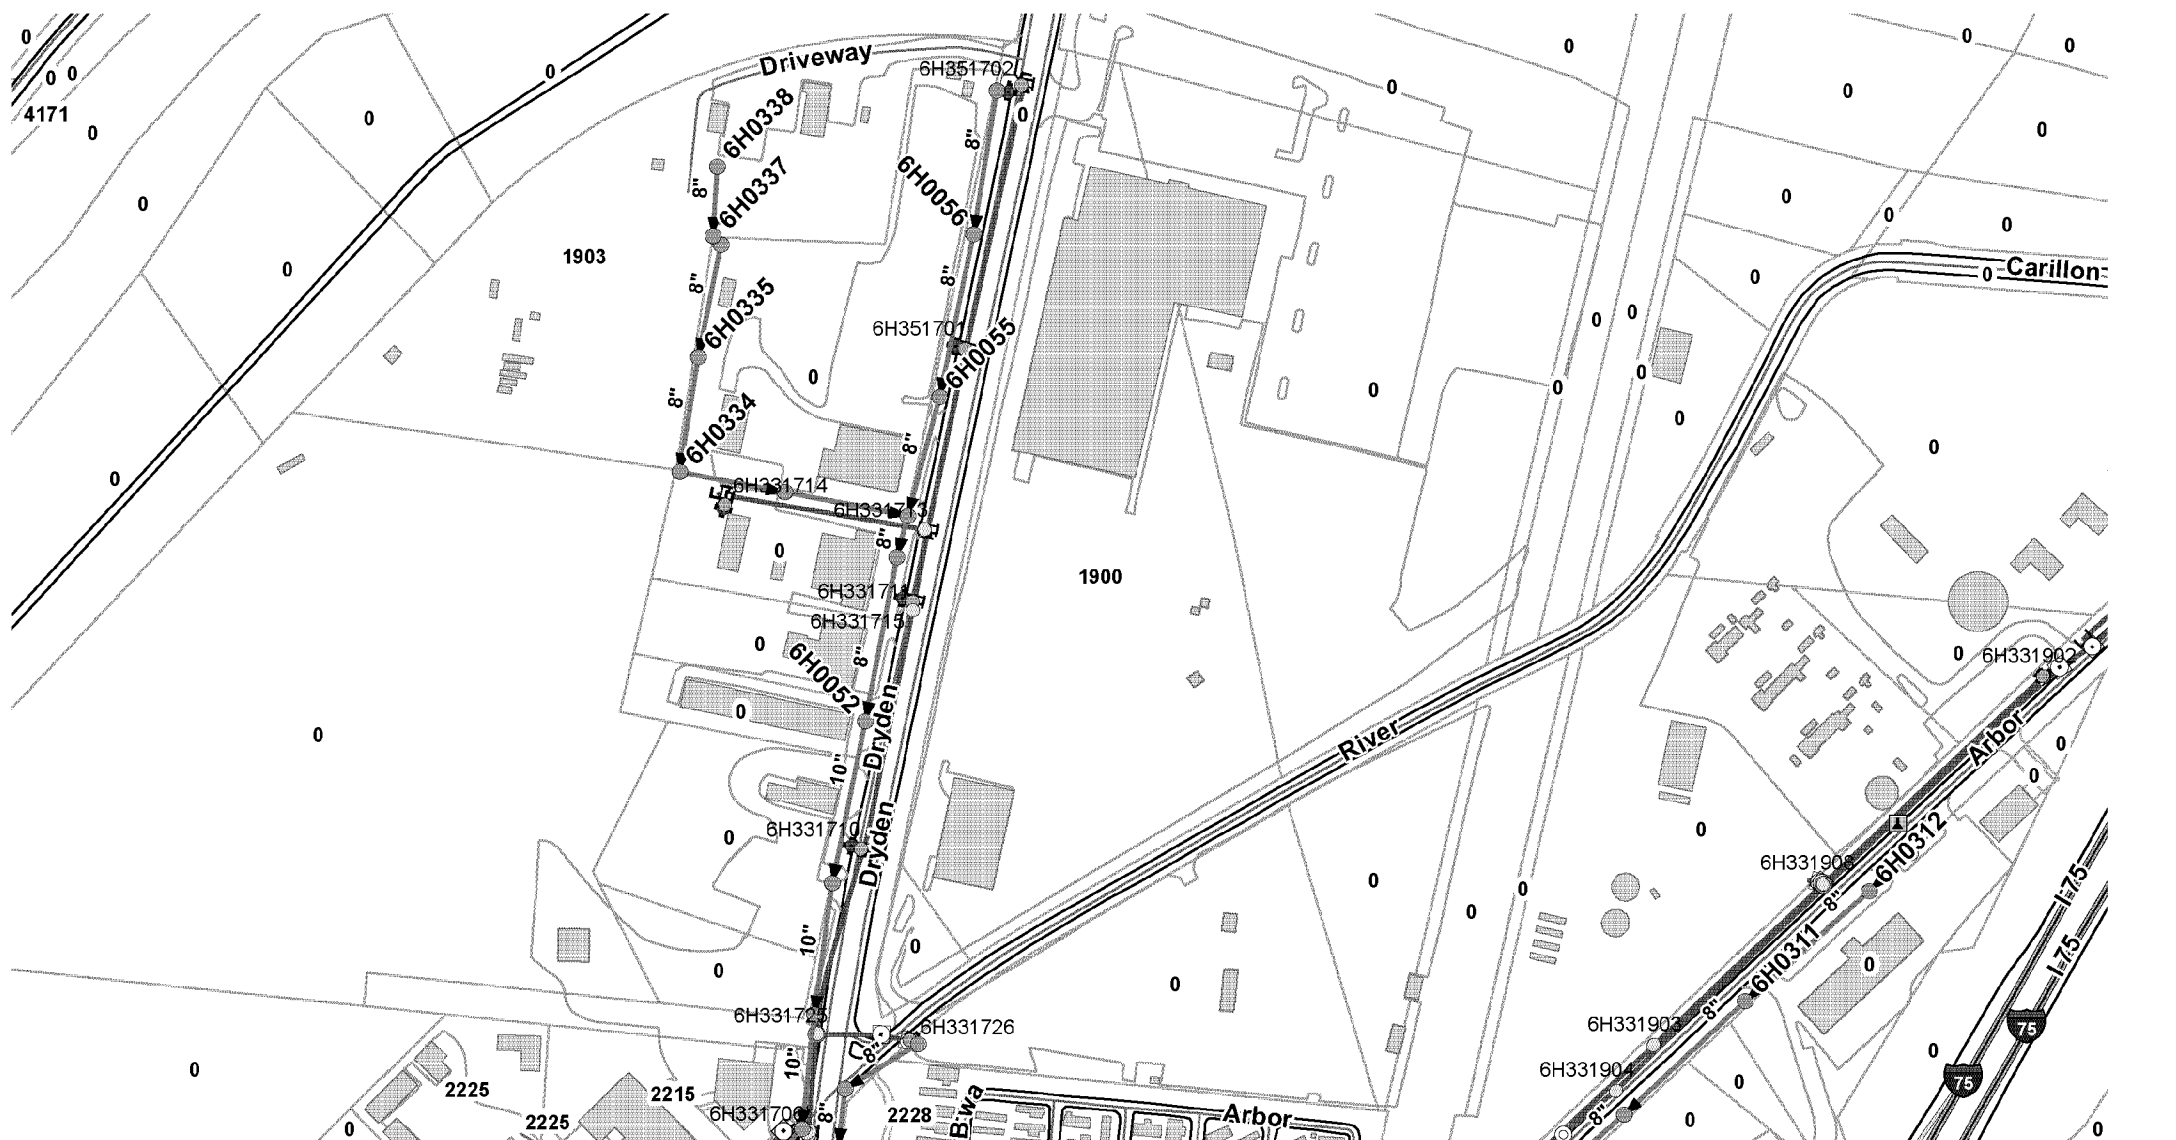

Chan, Valerie

From: Harden, Richard <HardenR@mcoho.org>
Sent: Wednesday, August 31, 2016 2:02 PM
To: Chan, Valerie
Subject: RE: OUPS Ticket A623702683

We do not show Storm on our GIS
The Green is Sanitary
Water is Blue
Yellow is Main Line Vales
Peach is Hydrant Vales
Red are Fire Hydrants
Broadway and Springboro Pike change at the River with Broadway being in the City of Dayton

From: Chan, Valerie [<mailto:Valerie.Chan@ghd.com>]
Sent: Monday, August 29, 2016 4:40 PM
To: Harden, Richard
Cc: Baker, Keith
Subject: RE: OUPS Ticket A623702683

Hello Richard,

Thank you for the figures. I had a few questions:

- Is there a legend available for the Attachment A623702683.pdf?
- Does Montgomery County have figures showing storm sewer locations, in addition to the sanitary sewer figures provided? If not, do you know which company I should contact for that information?
- Is S Broadway the same as Springboro Pike aka Dryden Road in the attached TIF?

Thank you,
Valerie

Valerie Chan, P.Eng.

GHD

T: 1 519 884 0510 | F: 1 519 884 0525 | E: valerie.chan@ghd.com
651 Colby Drive Waterloo Ontario N2V 1C2 Canada | www.ghd.com

[WATER](#) | [ENERGY & RESOURCES](#) | [ENVIRONMENT](#) | [PROPERTY & BUILDINGS](#) | [TRANSPORTATION](#)

Please consider our environment before printing this email

From: Harden, Richard [<mailto:HardenR@mcoho.org>]
Sent: Friday, August 26, 2016 2:34 PM
To: Chan, Valerie
Cc: Baker, Keith
Subject: OUPS Ticket A623702683

Valerie, Here are the drawings for this OUPS ticket. If there is anything else you need, please let me know.

Rich Harden
GIS/CAD Tech.
Environmental Services
Field Services
1850 Spaulding Rd.
Kettering, Ohio 45432
(937) 781-2549

Attachment 2

Chan, Valerie


From: Cox, David <David.Cox@cinbell.com>
Sent: Thursday, August 25, 2016 12:55 PM
To: Chan, Valerie
Subject: OUPS response
Attachments: 000001_2(crop).pdf

OUPS # A623702683
Subject Area: 1900 Dryden rd
Status: CBT has underground utilities in requested area, reference attachment

David Cox
Conduit Group Clerk, Cincinnati Bell
Phone: 513-565-0062
Cell: 513-502-8702
Email: david.cox@cinbell.com

The information transmitted is intended only for the person or entity to which it is addressed and may contain confidential and/or privileged material. Any review, retransmission, dissemination or other use of, or taking of any action in reliance upon, this information by persons or entities other than the intended recipient is prohibited. If you receive this in error, please contact the sender and destroy any copies of this document.

This e-mail has been scanned for viruses

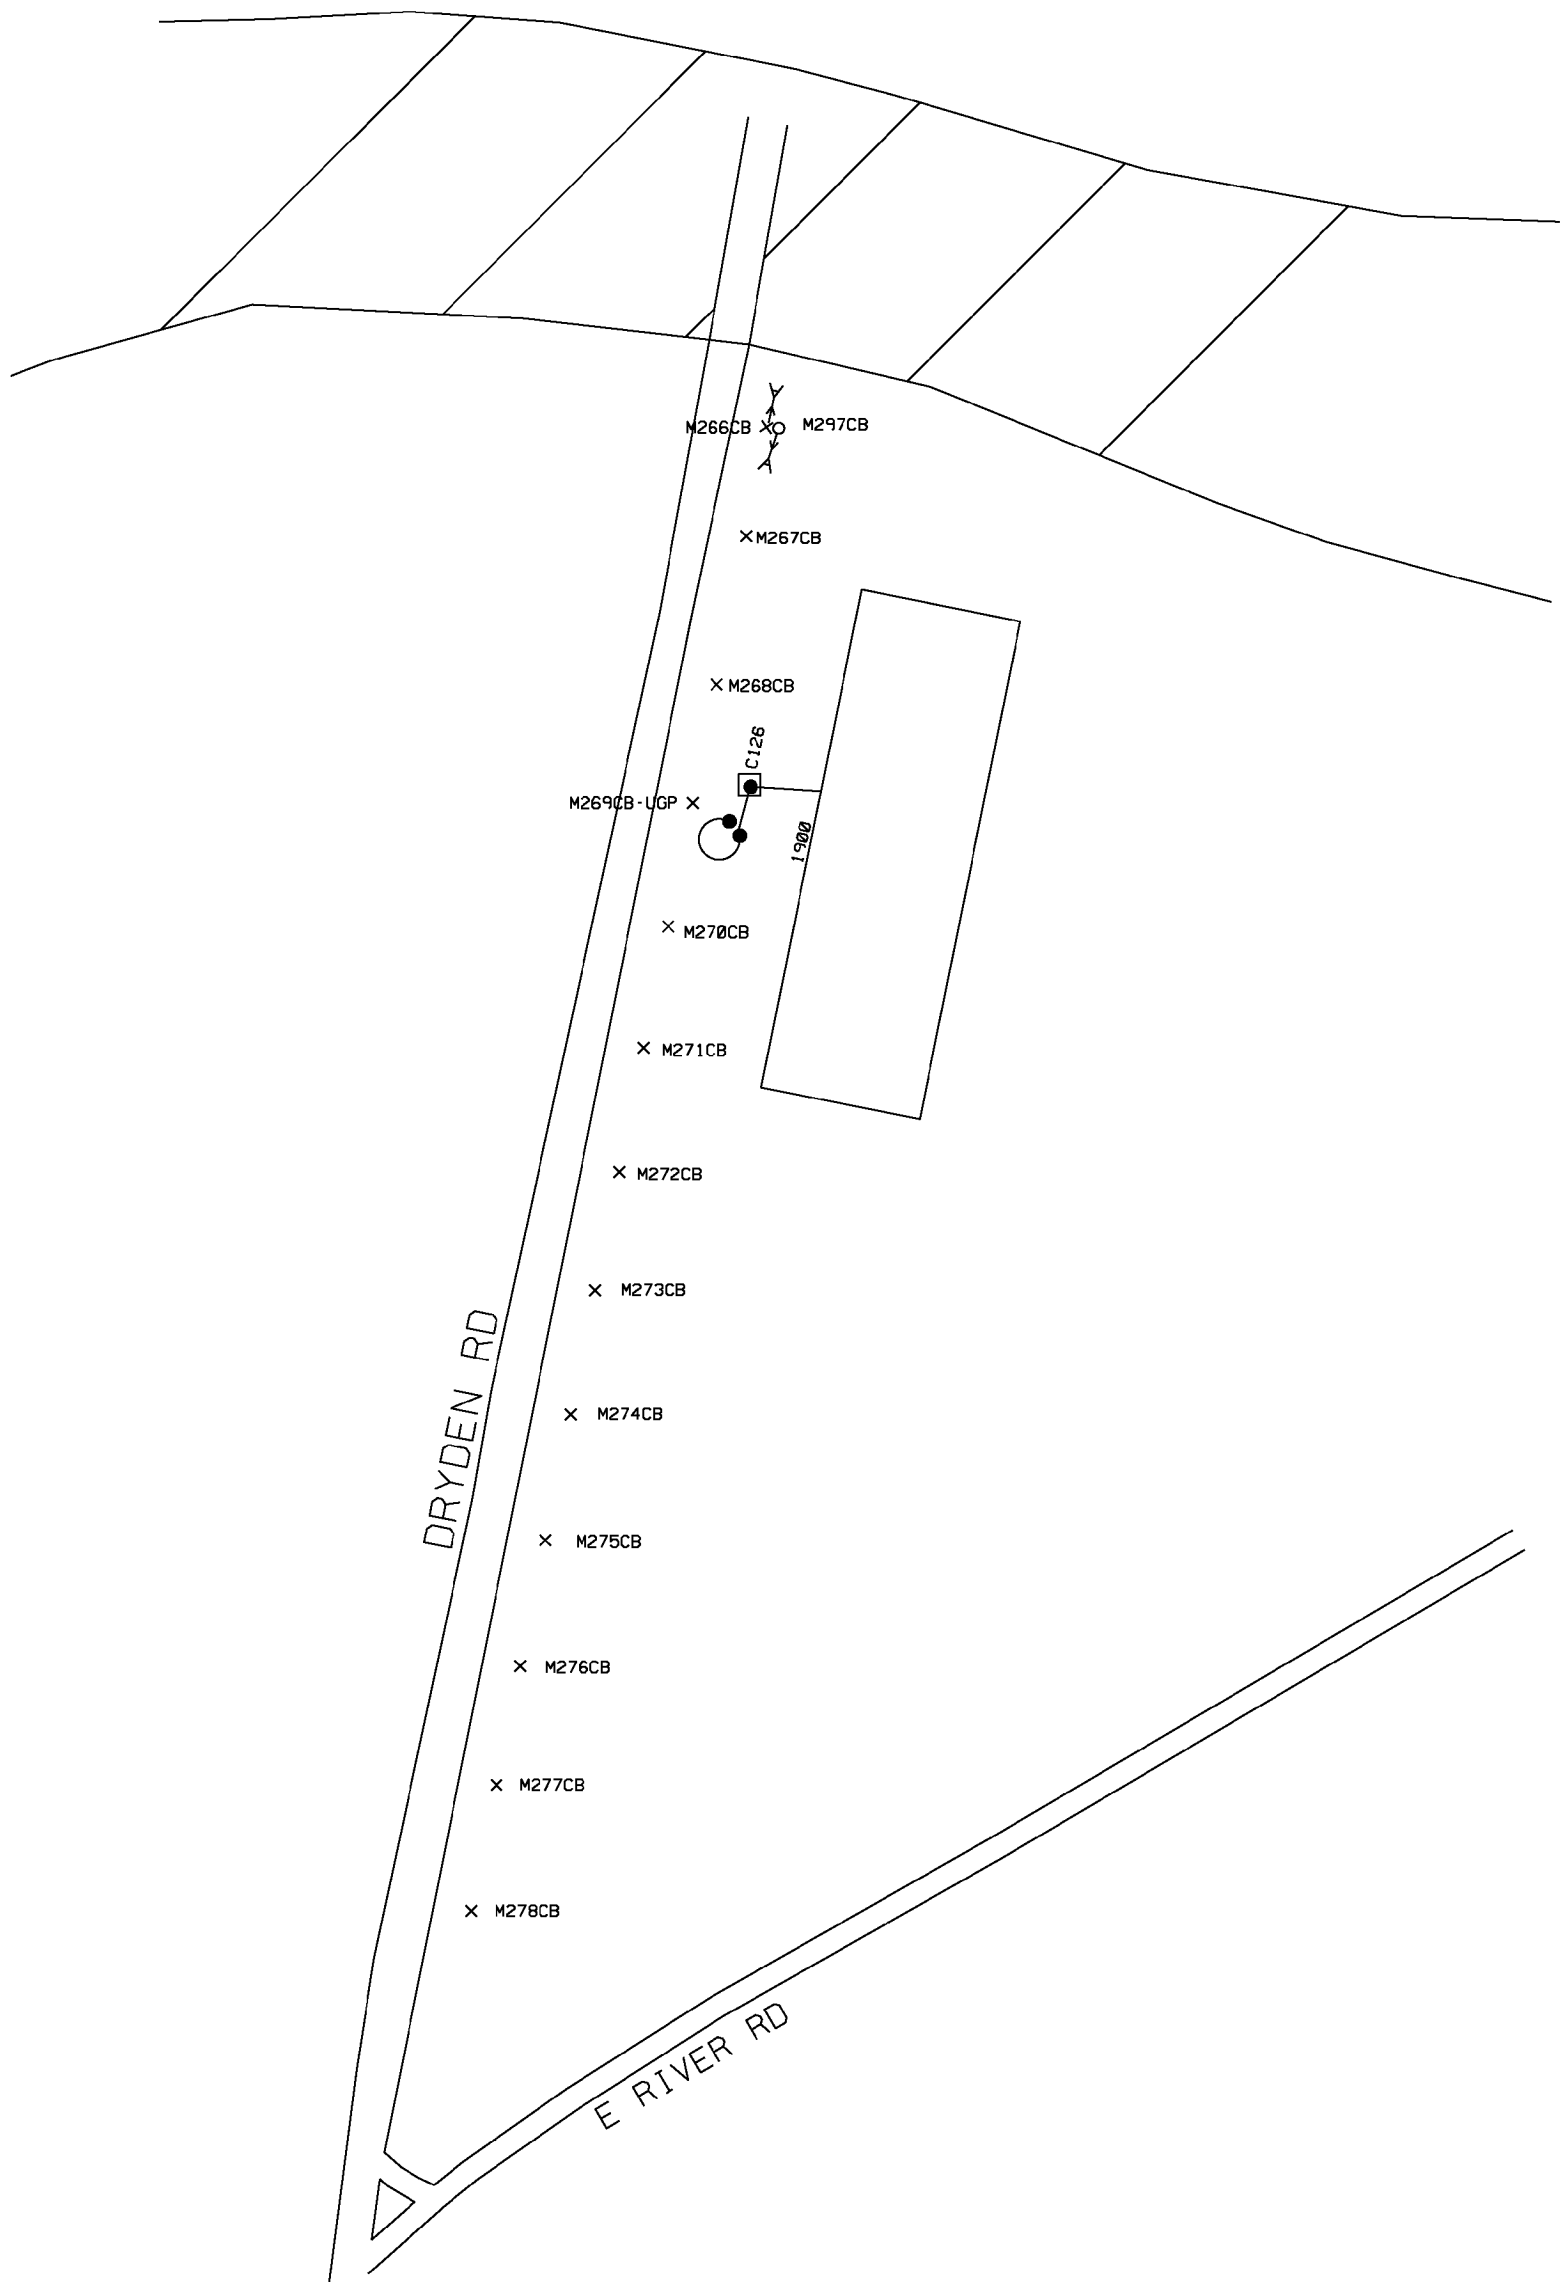

Chan, Valerie

From: alcs@zlp13991.vci.att.com
Sent: Wednesday, August 24, 2016 1:29 PM
To: Chan, Valerie
Subject: HIGH PRIORITY FACILITY FOUND



AT&T DAMAGE PREVENTION

*****FIBER OPTIC UTILITY LOCATE NOTIFICATION*****

Ticket #: {A623702683}
Ticket Address: {1900 DRYDEN RD} {MORaine}
Caller Name & Phone: {VALERIE CHAN} {519-884-0510 Ext: 2296}
Contractor Name & Phone: {GHD} {}

**THIS LOCATE REQUEST IS NEAR AN AT&T HIGH PROFILE FIBER OPTIC FACILITY;
BEFORE DIGGING IN THIS AREA WAIT ON THE LOCATES TO BE PERFORMED ;
TAKE CARE TO OBSERVE SITE MARKINGS SUCH AS PAINT AND FLAGS ;
HAND DIGGING IS MANDATORY WITHIN THE STATUTORY TOLERANCE ZONE,
DAMAGE PREVENTION IS EVERYONES RESPONSIBILITY.
THANK YOU.**

Contact Information

Positive Response : Excavator may use this link to check for positive response.
<http://www.oups.org/positive-response>

AT&T Distribution Damage Prevention: If assistance is needed during an excavation involving AT&T facilities or locate issues.

Briant Thomas, 231-409-7939

One Call Center: Any questions pertaining to a dig ticket should be directed to the state One Call (for example: location requested, utilities in the area or notification processes).

Ohio Utility Protection Services, 800-362-2764

AT&T Distribution Locate Vendor: If assistance is needed with interpretation of markings or locate issues contact the locate company for area.

USIC Dispatch Center, 800-762-0592

Damage Reporting to AT&T Distribution:
888-611-4466 prompt #8

This e-mail has been scanned for viruses

Chan, Valerie

From: agt_comm@irth.com
Sent: Thursday, August 25, 2016 11:12 PM
To: Chan, Valerie
Subject: Ticket A623702683 - Response to Dig Request

=====

To: GHD Attn: VALERIE CHAN

Voice: 5198840510 x2296 Fax:

Re: Response to Dig Request

Hello, this is an important message from Sprint Nextel regarding your request to locate our underground facilities in an area described on the one call center ticket.

=====

Ticket: A623702683

County: MONTGOMERY Place: MORaine

Address: 1900 DRYDEN RD

SPTP:

. Sprint Nextel facilities are clear from the work area described on this One-Call Center ticket. If you have any questions or concerns, please call Sprint Nextel Call Before You Dig at 1-800-521-0579.

=====

If you have any questions please contact Sprint at 800-521-0579 that number again is Sprint at 800-521-0579.

=====

This message was generated by an automated system. Please do not reply to this email.

This e-mail has been scanned for viruses

Chan, Valerie

From: IRTH.Net@CenturyLink.com
Sent: Friday, September 02, 2016 8:14 AM
To: Chan, Valerie
Subject: Centurylink Locate Notification

=====

To: GHD Attn: VALERIE CHAN

Voice: 5198840510 x2296 Fax:

Re: Centurylink Locate Notification

Message from CenturyLink

This is an important message from CenturyLink

replying to your request to locate our underground facilities in an area

described on the one call center ticket. If you have any questions please call

CenturyLink at 1-800-283-4237

=====

Ticket: A623702683

County: MONTGOMERY Place: MORaine

Address: 1900 DRYDEN RD

QSTP:

The described dig area of your locate request has been checked and is clear for

CenturyLink National Network, but may be a risk to CenturyLink local. If you

have any questions, please call CenturyLink at 1-800-283-4237. CenturyLink

has closed this ticket.

Centurylink

=====

This message was generated by an automated system. Please do not reply to this email.

This e-mail has been scanned for viruses

Chan, Valerie

From: Schaffer, Charles <SchafferC@mcoho.org>
Sent: Friday, September 09, 2016 5:57 PM
To: Hayward, Julian
Subject: RE: Dryden Road storm sewer
Attachments: DOC090916-09092016175430.pdf; DOC090916-09092016175201.pdf

Attached is a copy of the Water and sanitary sewer atlas in this area. I have also attached a copy of the as-built drawing for Arbor And Carrillon that does show some stm. Sewers. Unfortunately where you have requested we do not have our utilities.

From: Hayward, Julian [<mailto:Julian.Hayward@ghd.com>]
Sent: Friday, September 09, 2016 5:10 PM
To: Schaffer, Charles
Subject: RE: Dryden Road storm sewer

OK, it is the section of Dryden Road within the area depicted below, more specifically the part between the river to the north and East River Road to the south.

Thanks



Julian Hayward

GHD

T: +1 519 884 0510 | M: +1 519 503 3627 | E: julian.hayward@ghd.com

From: Schaffer, Charles [<mailto:SchafferC@mcoho.org>]

Sent: Friday, September 09, 2016 4:30 PM

To: Hayward, Julian; schaffercharlie@mcoho.org

Subject: RE: Dryden Road storm sewer

Please provide a map as to the exact location you are looking at. I will see if anything shows up on our as-built drawings of our utilities.

From: Hayward, Julian [<mailto:Julian.Hayward@ghd.com>]

Sent: Friday, September 09, 2016 2:42 PM

To: schaffercharlie@mcoho.org; Schaffer, Charles

Subject: Dryden Road storm sewer

Mr. Schaffer,

I was given your name by Tony Wenzler at City of Moraine, he indicated you may be able to assist with my inquiry.

I am working on an environmental investigation in the area of Dryden Road, specifically the section from East River Road extending northward toward the bridge that crosses the river.

The investigation requires some knowledge of buried infrastructure. I have some details from OUPS for sanitary sewer, water, gas etc. but they were not able to provide anything for the storm sewer system.

Would you be able to provide drawings showing the layout of the existing storm sewer system within the area noted above?

Thanks

Julian Hayward, P.Eng.

GHD

T: +1 519 884 0510 | M: +1 519 503 3627 | E: julian.hayward@ghd.com

651 Colby Drive Waterloo Ontario N2V 1C2 Canada | www.ghd.com

WATER | ENERGY & RESOURCES | ENVIRONMENT | PROPERTY & BUILDINGS | TRANSPORTATION

Please consider our environment before printing this email

CONFIDENTIALITY NOTICE: This email, including any attachments, is confidential and may be privileged. If you are not the intended recipient please notify the sender immediately, and please delete it; you should not copy it or use it for any purpose or disclose its contents to any other person. GHD and its affiliates reserve the right to monitor and modify all email communications through their networks.

This e-mail has been scanned for viruses

CONFIDENTIALITY NOTICE: This email, including any attachments, is confidential and may be privileged. If you are not the intended recipient please notify the sender immediately, and please delete it; you should not copy it or use it for any purpose or disclose its contents to any other person. GHD and its affiliates reserve the right to monitor and modify all email communications through their networks.

Chan, Valerie

From: Schaffer, Charles <SchafferC@mcoho.org>
Sent: Monday, September 12, 2016 10:42 AM
To: Hayward, Julian
Subject: RE: Dryden Road storm sewer

Green is sanitary sewers , blue is water mains the Manhole numbers are next to the sanitary manhole circles. Red dots are fire hydrants yellow dots should be water valves. White dots are bends or fitting on the water main. The size of the water main or sanitary sewer main are labeled in blue or green accordingly. The white manholes in the trailer park are private manholes.

I hope this helps.

From: Hayward, Julian [mailto:Julian.Hayward@ghd.com]
Sent: Monday, September 12, 2016 9:27 AM
To: Schaffer, Charles
Subject: RE: Dryden Road storm sewer

Mr. Schaffer, could you provide a legend for the details shown on the arc gis web map (attached)?

I think green line is water main and blue line is sanitary sewer? Or other way around?

Also I can see some red and yellow dots.

Thanks again

Julian Hayward

GHD

T: +1 519 884 0510 | M: +1 519 503 3627 | E: julian.hayward@ghd.com



From: Schaffer, Charles [mailto:SchafferC@mcoho.org]
Sent: Friday, September 09, 2016 5:57 PM
To: Hayward, Julian
Subject: RE: Dryden Road storm sewer

Attached is a copy of the Water and sanitary sewer atlas in this area. I have also attached a copy of the as-built drawing for Arbor And Carrillon that does show some stm. Sewers. Unfortunately where you have requested we do not have our utilities.

From: Hayward, Julian [mailto:Julian.Hayward@ghd.com]
Sent: Friday, September 09, 2016 5:10 PM
To: Schaffer, Charles
Subject: RE: Dryden Road storm sewer

OK, it is the section of Dryden Road within the area depicted below, more specifically the part between the river to the north and East River Road to the south.

Thanks

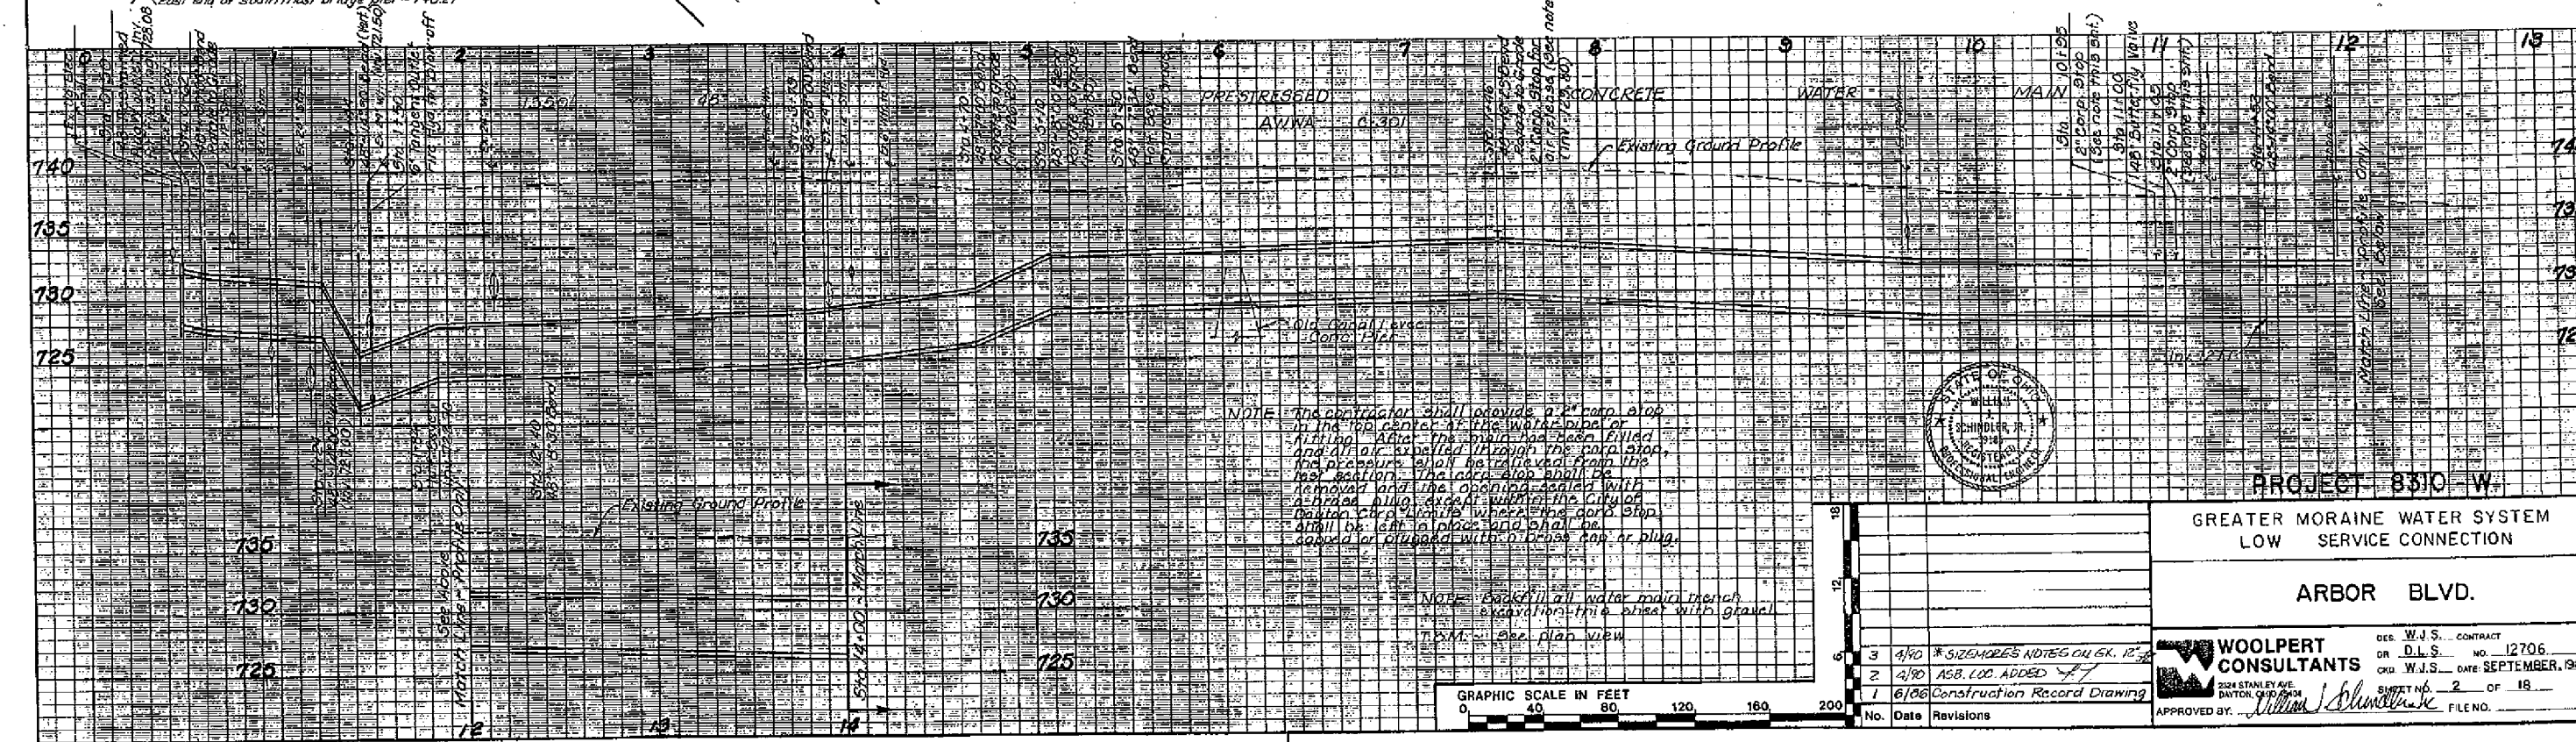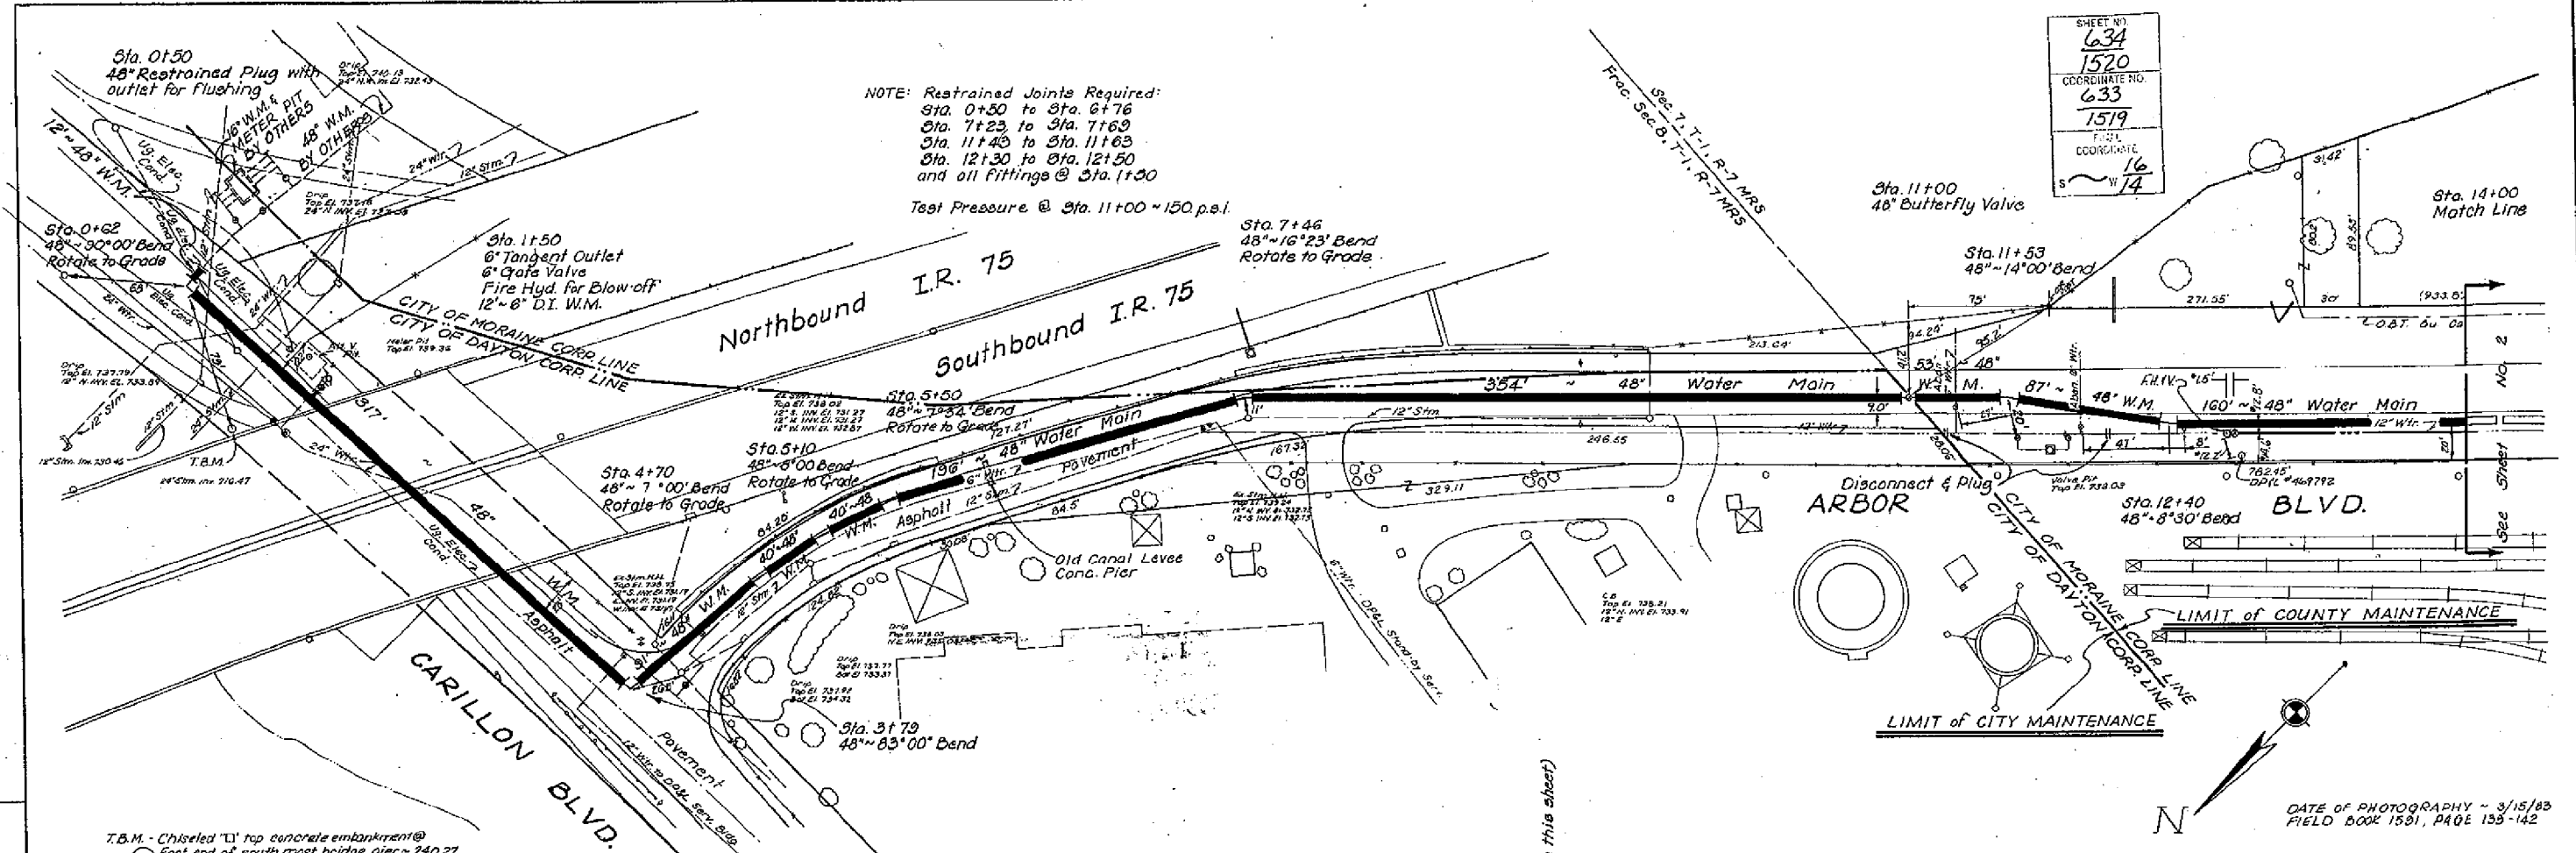

Chan, Valerie

From: East, Dominic <dominic.east@level3.com>
Sent: Monday, September 19, 2016 11:47 AM
To: Chan, Valerie
Subject: Return to Requestor - 1900 Dryden Rd
Attachments: Utility Map.pdf

Valerie,

Level 3 Communications, LLC ("Level 3") has received your utility notice dated 8/25/2016 regarding the 1900 Dryden Rd, Moraine OH ("Project"). In response to your inquiry please find the enclosed drawings indicating the approximate location of the Level 3 telecommunications facilities (the "Facilities"). Note that the locations of Facilities shown on these drawings are only approximate and Level 3 hereby disclaims any responsibility for the accuracy of this information. Persons working in the area covered by these drawings must contact the statewide Call-Before-You-Dig System to ascertain the location of underground facilities prior to performing any excavation.

After reviewing the information you provided it is uncertain whether the Project will impact the Facilities.


The Facilities have been constructed on private property and/or public right of way with the authorization of the applicable property owner. Prior to any work being performed by or on behalf of Level 3 all costs associated with the adjustment and/or relocation of the Facilities are required to be paid in full to Level 3.

Please review the enclosed information. If it is determined that an adjustment and/or relocation of the Facilities is necessary to accommodate the Project, please contact the undersigned to discuss and reference the file number **65368 GL** with any future communications. Any changes or additions to the Project plans or parameters should be submitted to Level 3 for review of potential new impacts to the Level 3 facilities. Unless Level 3 receives information that such adjustment or relocation is necessary it will assume that any potential conflict between the Project and Facilities has been eliminated.

Thank you,

Dominic East
Business Analyst, OSP Relocations
Level 3 Communications
1025 El Dorado Blvd
Broomfield, CO 80021
p: 720.888.4398
e: dominic.east@level3.com

This e-mail has been scanned for viruses

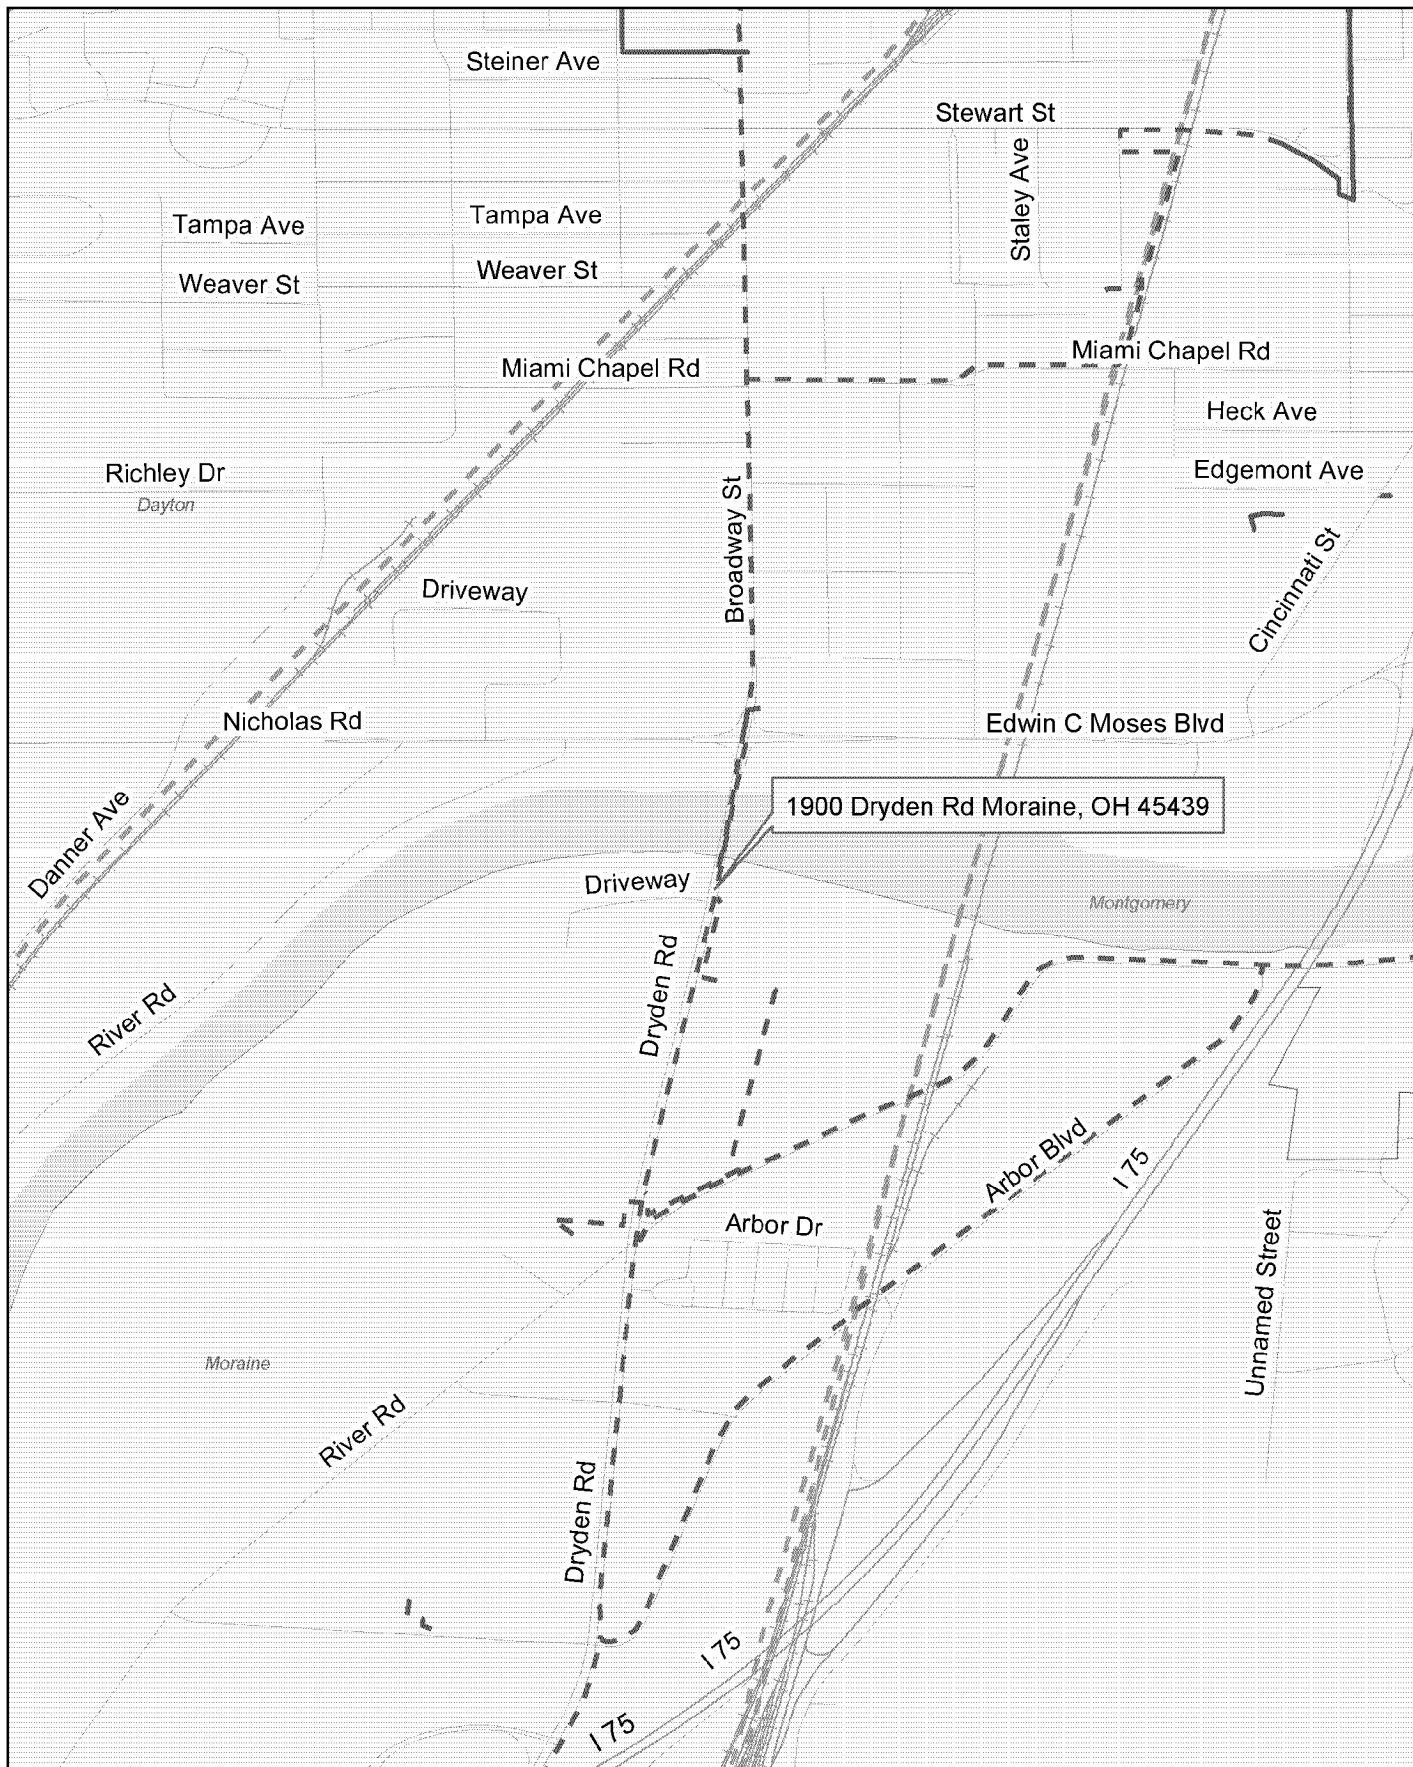

Legend

Level 3 Facilities

- Aerial
- - - Underground

Non-Level 3 Fiber Optic Facilities

- Aerial
- - - Underground

Note that the locations of Facilities shown on these drawings are only approximate and Level 3 hereby disclaims any responsibility to third parties for the accuracy of this information. Persons working in the area covered by these drawings must contact the statewide Call-Before-You-Dig System to ascertain the location of underground facilities prior to performing any excavation.

Attachment 3




STRATIGRAPHIC AND INSTRUMENTATION LOG (OVERBURDEN)

Page 1 of 1

PROJECT NAME: SOUTH DAYTON DUMP
PROJECT NUMBER: 038443
CLIENT: ILLINOIS TOOL WORKS INC
LOCATION: MORAIN, OHIO

HOLE DESIGNATION: GP11-09
DATE COMPLETED: August 20, 2009
DRILLING METHOD: GEOPROBE
FIELD PERSONNEL: J. CLOSE
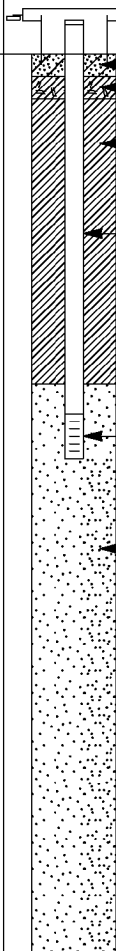
| DEPTH ft BGS | STRATIGRAPHIC DESCRIPTION & REMARKS | ELEV. ft | MONITORING WELL | SAMPLE | | | | |
|-----------------|--|-------------|--|--------|----------|---------|-----------|-----------|
| | | | | NUMBER | INTERVAL | REC (%) | 'N' VALUE | PID (ppm) |
| | GROUND SURFACE | 730.48 |  <p>CEMENT BENTONITE CHIPS BENTONITE 0.5" PVC WELL CASING 2" BOREHOLE 0.5" PVC WELL SCREEN SAND PACK</p> | | | | | |
| 2 | SW/GW - SAND AND GRAVEL (FILL), medium to coarse sand, fine gravel, loose, well graded, brown/tan/off-white, dry | 728.88 | | 1GP | | 70 | | 0.0 |
| 4 | SM - SAND AND SILT (FILL), fine to medium sand, cohesive, dark gray/black, dry | | | | | | | |
| 6 | - gravel and sand at 4.6ft BGS | | | | | | | |
| 8 | | | | 2GP | | 70 | | 0.0 |
| 10 | - crushed stone at 8.5ft BGS | | | | | | | |
| 12 | | | | | | | | |
| 14 | SW - SAND, little fine gravel, medium to coarse sand, loose, well graded, brown, dry | 718.48 | | 3GP | | 70 | | 0.0 |
| 16 | | | | | | | | |
| 18 | | | | 4GP | | 70 | | 0.0 |
| 20 | | | | | | | | |
| 22 | GW/SW - SAND AND GRAVEL, medium to coarse sand, fine gravel, loose, brown, dry | 716.98 | <p><u>WELL DETAILS</u> Screened interval: 722.48 to 721.48ft 8.00 to 9.00ft BGS Length: 1ft Diameter: 0.5in Slot Size: 0.010 Material: PVC Seal: 729.48 to 723.15ft 1.00 to 7.33ft BGS Material: BENTONITE CHIPS Sand Pack: 723.15 to 710.48ft 7.33 to 20.00ft BGS Material: #3 SAND</p> | 5GP | | 80 | | 0.0 |
| 24 | - wet at 22.0ft BGS | | | | | | | |
| 26 | END OF BOREHOLE @ 25.0ft BGS | 705.48 | | | | | | |
| 28 | | | | | | | | |
| | | | | | | | | |

NOTES: MEASURING POINT ELEVATIONS MAY CHANGE; REFER TO CURRENT ELEVATION TABLE

OVERBURDEN LOG 38443-60 GAS PROBES.GPJ CRA_CORP.GDT: 2/5/10



STRATIGRAPHIC AND INSTRUMENTATION LOG (OVERBURDEN)

Page 1 of 1

PROJECT NAME: SOUTH DAYTON DUMP

PROJECT NUMBER: 038443

CLIENT: ILLINOIS TOOL WORKS INC


LOCATION: MORAINES, OHIO

HOLE DESIGNATION: GP12-09

DATE COMPLETED: August 21, 2009

DRILLING METHOD: GEOPROBE

FIELD PERSONNEL: J. CLOSE
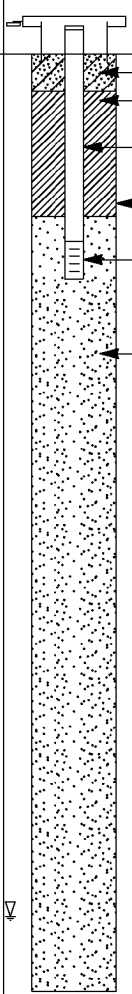
| DEPTH ft BGS | STRATIGRAPHIC DESCRIPTION & REMARKS | ELEV. ft | MONITORING WELL | SAMPLE | | | | |
|-----------------|--|-------------|--|--------|----------|---------|-----------|-----------|
| | | | | NUMBER | INTERVAL | REC (%) | 'N' VALUE | PID (ppm) |
| | GROUND SURFACE | 730.61 |  | | | | | |
| 2 | SW - SAND (FILL), trace silt, trace fine gravel, medium to coarse grained sand, loose, well graded, brown, dry | | CEMENT BENTONITE 0.5" PVC WELL CASING 2" BOREHOLE 0.5" PVC WELL SCREEN SAND PACK | 1GP | | 50 | | 0.0 |
| 4 | | | | | | | | |
| 6 | - red clay brick fragments at 6.0ft BGS ML - SANDY SILT (FILL), cohesive, dark brown, damp | 724.51 | | 2GP | | 80 | | 0.0 |
| 8 | - rock fragments at 7.8ft BGS SW/GW - SAND AND GRAVEL, medium to coarse sand, fine gravel, loose, well graded, light brown/tan, dry | 723.11 | | | | | | |
| 10 | - rock fragments at 9.3ft BGS | | | 3GP | | 70 | | 0.0 |
| 12 | | | | | | | | |
| 14 | - rock fragments at 13.0ft BGS - rock fragments at 14.2ft BGS | | | 4GP | | 70 | | 0.0 |
| 16 | | | | | | | | |
| 18 | - rock fragments at 17.0ft BGS | | | 5GP | | 60 | | 0.0 |
| 20 | | | | | | | | |
| 22 | | | | | | | | |
| 24 | | | | | | | | |
| 26 | END OF BOREHOLE @ 25.0ft BGS | 705.61 | <u>WELL DETAILS</u> Screened Interval: 725.61 to 724.61ft 5.00 to 6.00ft BGS Length: 1ft Diameter: 0.5in Slot Size: 0.010 Material: PVC Seal: 729.61 to 726.28ft 1.00 to 4.33ft BGS Material: BENTONITE Sand Pack: 726.31 to 705.61ft 4.30 to 25.00ft BGS Material: #3 SAND | | | | | |
| 28 | | | | | | | | |
| 30 | | | | | | | | |
| 32 | | | | | | | | |
| 34 | | | | | | | | |

NOTES: MEASURING POINT ELEVATIONS MAY CHANGE; REFER TO CURRENT ELEVATION TABLE
WATER FOUND ∇

OVERBURDEN LOG 38443-60 GAS PROBES.GPJ CRA CORP.GDT: 2/5/10



STRATIGRAPHIC AND INSTRUMENTATION LOG (OVERBURDEN)

Page 1 of 1

PROJECT NAME: SOUTH DAYTON DUMP

HOLE DESIGNATION: GP19-09

PROJECT NUMBER: 038443



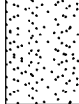
DATE COMPLETED: August 24, 2009

CLIENT: ILLINOIS TOOL WORKS INC

DRILLING METHOD: GEOPROBE

LOCATION: MORAINES, OHIO

FIELD PERSONNEL: J. CLOSE
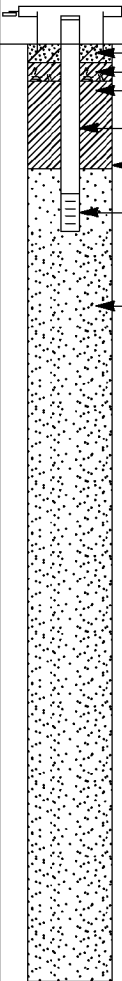
| DEPTH ft BGS | STRATIGRAPHIC DESCRIPTION & REMARKS | ELEV. ft | MONITORING WELL | SAMPLE | | | | |
|---|---|-------------|--|--------|----------|---------|-----------|-----------|
| | | | | NUMBER | INTERVAL | REC (%) | 'N' VALUE | PID (ppm) |
| | GROUND SURFACE | 734.23 |  | | | | | |
| 2 | GW/SW - SAND AND GRAVEL (FILL), fine, medium and coarse sand, fine gravel, loose, well graded, brown | 731.23 |  | 1GP | | 70 | | 0.0 |
| 4 | SW - SAND (FILL), fine, medium and coarse sand, little fine gravel, well graded, medium to dark gray, dry - bottom of FILL at 22.5ft BGS | | | | | | | |
| 6 | | | | 2GP | | 50 | | 0.0 |
| 8 | | | | | | | | |
| 10 | | | | 3GP | | 40 | | |
| 12 | | | | | | | | |
| 14 | - pieces of glass at 14.0ft BGS | | | | | | | 4.5 |
| 16 | | | | | | | | |
| 18 | | | | 4GP | | 40 | | 0.0 |
| 20 | - 1' perched H ₂ O at 19.0ft BGS | | | | | | | |
| 22 | | 711.73 |  | 5GP | | 74 | | 0.0 |
| 24 | SW/GW - SAND AND GRAVEL, loose, well graded, brown to medium brown, dry | | | | | | | |
| 26 | END OF BOREHOLE @ 25.0ft BGS | 709.23 | | | | | | |
| 28 | | | <u>WELL DETAILS</u> Screened Interval: 730.23 to 729.23ft 4.00 to 5.00ft BGS Length: 1ft Diameter: 0.5in Slot Size: 0.010 Material: PVC Seal: 733.23 to 730.90ft 1.00 to 3.33ft BGS Material: BENTONITE CHIPS Sand Pack: 730.90 to 709.23ft 3.33 to 25.00ft BGS Material: #3 SAND | | | | | |
| 30 | | | | | | | | |
| 32 | | | | | | | | |
| 34 | | | | | | | | |
| <u>NOTES:</u> MEASURING POINT ELEVATIONS MAY CHANGE; REFER TO CURRENT ELEVATION TABLE | | | | | | | | |

OVERBURDEN LOG 38443-60 GAS PROBES.GPJ CRA_CORP.GDT 2/5/10



STRATIGRAPHIC AND INSTRUMENTATION LOG (OVERBURDEN)

Page 1 of 1

PROJECT NAME: SOUTH DAYTON DUMP
PROJECT NUMBER: 038443
CLIENT: ILLINOIS TOOL WORKS INC
LOCATION: MORaine, OHIO

HOLE DESIGNATION: GP20-09
DATE COMPLETED: August 24, 2009
DRILLING METHOD: GEOPROBE
FIELD PERSONNEL: J. CLOSE

| DEPTH ft BGS | STRATIGRAPHIC DESCRIPTION & REMARKS | ELEV. ft | MONITORING WELL | SAMPLE | | | | |
|-----------------|--|-------------|---|--------|----------|---------|-----------|-----------|
| | | | | NUMBER | INTERVAL | REC (%) | 'N' VALUE | PID (ppm) |
| | GROUND SURFACE | 731.51 | <p>CEMENT BENTONITE CHIPS BENTONITE 0.5" PVC WELL CASING 2" BOREHOLE 0.5" PVC WELL SCREEN SAND PACK</p> | | | | | |
| 2 | SW/GW - SAND AND GRAVEL (FILL), medium to coarse sand, fine gravel, loose, well graded, brown, dry | | | 1GP | | 70 | | 0.0 |
| 4 | SW - SAND (FILL), fine to medium sand, silt, consolidated, well graded, dark gray, moist | 727.51 | | | | | | |
| 6 | - rust sand at 6.5ft BGS | | | 2GP | | 60 | | 0.0 |
| 8 | - 1' gray sand, wet (perched water) at 7.0ft BGS | | | | | | | |
| | - foundry-type sand at 8.5ft BGS | | | | | | | |
| 10 | SW/GW - SAND AND GRAVEL (FILL), medium to coarse sand, fine gravel, silt, well graded, brown, dry | 722.51 | | 3GP | | 80 | | 0.0 |
| 12 | | | | | | | | |
| 14 | | | | | | | | |
| 16 | - rock fragments at 16.7ft BGS | | | 4GP | | 60 | | 0.0 |
| 18 | | | | | | | | |
| 20 | | | | | | | | |
| 22 | | | | 5GP | | 60 | | 0.0 |
| 24 | - wet at 23.7ft BGS | | | | | | | |
| 26 | END OF BOREHOLE @ 25.0ft BGS | 706.51 | <p>WELL DETAILS Screened Interval: 727.51 to 726.51ft 4.00 to 5.00ft BGS Length: 1ft Diameter: 0.5in Slot Size: 0.010 Material: PVC Seal: 730.51 to 728.18ft 1.00 to 3.33ft BGS Material: BENTONITE CHIPS Sand Pack: 728.18 to 706.51ft 3.33 to 25.00ft BGS Material: #3 SAND</p> | | | | | |
| 28 | | | | | | | | |
| 30 | | | | | | | | |
| 32 | | | | | | | | |
| 34 | | | | | | | | |

NOTES: MEASURING POINT ELEVATIONS MAY CHANGE; REFER TO CURRENT ELEVATION TABLE
WATER FOUND ∇

OVERBURDEN LOG 38443-60 GAS PROBES.GPJ CRA_CORP.GDT 2/5/10



STRATIGRAPHIC AND INSTRUMENTATION LOG (OVERBURDEN)

Page 1 of 1

PROJECT NAME: SOUTH DAYTON DUMP AND LANDFILL SITE
PROJECT NUMBER: 038443-62-03
CLIENT: PRP GROUP
LOCATION: MORaine, OH

HOLE DESIGNATION: GP22-13
DATE COMPLETED: July 3, 2013
DRILLING METHOD: GEOPROBE
FIELD PERSONNEL: J. CLOSE

| DEPTH ft BGS | STRATIGRAPHIC DESCRIPTION & REMARKS | DEPTH ft BGS | SOIL GAS PROBE | SAMPLE | | | | |
|-----------------|---|-----------------|----------------------------|--------|----------|----------|-----------|-----------|
| | | | | NUMBER | INTERVAL | REC (ft) | 'N' VALUE | PID (ppm) |
| | TOPSOIL | 0.17 | | | | | | |
| 2 | SW-SAND (FILL), loose, trace fine gravel, fine to medium sand, some coarse sand, well graded, brown, dry | | CONCRETE | | | | | 0.0 |
| 4 | SP-SAND (FILL), slightly compact, fine grained, poorly graded, gray, dry - glass pieces at 4.0ft BGS - some coarse sand/fine gravel, brown at 4.5ft BGS | 2.80 5.00 | BENTONITE CHIPS | 1GP | | 3.8 | | 0.0 |
| 6 | SW-SAND (FILL), little fine gravel, loose, medium to coarse sand, well graded, brown/black, dry | | 1/2" PVC WELL CASING | | | | | 0.0 |
| 8 | | | 2 1/4" BOREHOLE | 2GP | | 3.7 | | 49.9 |
| 10 | | | | | | | | 41.5 |
| 12 | | | | 3GP | | 3.2 | | 26.2 |
| 14 | | | | | | | | |
| 16 | | | | 4GP | | 0.0 | | 0.0 |
| 18 | | | SAND PACK | | | | | |
| 20 | SW/GW-SILTY SAND/GRAVEL, loose, fine, medium and coarse sand, fine gravel, brown, dry | 19.00 20.00 | 1/4" HOLED PVC WELL SCREEN | | | | | |
| 22 | END OF BOREHOLE @ 20.0ft BGS | | | | | | | |
| 24 | | | | | | | | |
| 26 | | | | | | | | |
| 28 | | | | | | | | |

WELL DETAILS
Screened interval:
19.00 to 20.00ft BGS
Length: 1ft
Diameter: 0.5in
Slot Size: 0.25
Material: PVC
Seal:
2.00 to 18.20ft BGS
Material: BENTONITE CHIPS
Sand Pack:
19.00 to 20.00ft BGS
Material: #3 SAND

NOTES: MEASURING POINT ELEVATIONS MAY CHANGE; REFER TO CURRENT ELEVATION TABLE

CHEMICAL ANALYSIS

OVERBURDEN LOG 038443-62-03 SOIL GAS PROBES JULY 2013 GP CRA CORP GDT 9/18/13



STRATIGRAPHIC AND INSTRUMENTATION LOG (OVERBURDEN)

Page 1 of 1

PROJECT NAME: SOUTH DAYTON DUMP AND LANDFILL SITE
PROJECT NUMBER: 038443-62-03
CLIENT: PRP GROUP
LOCATION: MORaine, OH

HOLE DESIGNATION: GP23-13
DATE COMPLETED: July 3, 2013
DRILLING METHOD: GEOPROBE
FIELD PERSONNEL: J. CLOSE

| DEPTH ft BGS | STRATIGRAPHIC DESCRIPTION & REMARKS | DEPTH ft BGS | SOIL GAS PROBE | SAMPLE | | | | |
|-----------------|--|-----------------|----------------------------|--------|----------|----------|-----------|-----------|
| | | | | NUMBER | INTERVAL | REC (ft) | 'N' VALUE | PID (ppm) |
| 2 | SW/GW-SAND/GRAVEL (FILL), loose, medium to coarse sand, fine to coarse gravel, well graded, brown/tan, dry | 1.80 | CONCRETE | 1GP | | 3.7 | | 0.3 |
| 4 | SW-SAND (FILL), trace fine gravel, medium to coarse sand, trace fine sand, well graded, gray, dry - red clay brick fragments at 3.0ft BGS - fine grained silty sand at 3.8ft BGS - silty sand/gravel at 4.5ft BGS | | BENTONITE CHIPS | | | | | 0.0 |
| 6 | | | 1/2" PVC WELL CASING | | | | | 0.0 |
| 8 | | | 2 1/4" BOREHOLE | 2GP | | 2.0 | | 2.6 |
| 10 | - wood pieces at 10.0ft BGS | | | | | | | 0.0 |
| 12 | | 12.00 | | | | | | 0.2 |
| 14 | GW/SW-SAND AND GRAVEL, medium to coarse sand, fine gravel, well graded | | | 3GP | | 2.4 | | 0.0 |
| 16 | | | | | | | | 0.0 |
| 18 | - silty, moist at 18.7ft BGS | | 1/4" HOLED PVC WELL SCREEN | 4GP | | 2.0 | | 0.0 |
| 20 | END OF BOREHOLE @ 20.0ft BGS | 20.00 | SAND PACK | | | | | 0.0 |
| 22 | | | | | | | | |
| 24 | | | | | | | | |
| 26 | | | | | | | | |
| 28 | | | | | | | | |

WELL DETAILS
Screened interval:
17.50 to 18.50ft BGS
Length: 1ft
Diameter: 0.5in
Slot Size: 0.25
Material: PVC
Seal:
2.00 to 16.70ft BGS
Material: BENTONITE CHIPS
Sand Pack:
16.70 to 20.00ft BGS
Material: #3 SAND

NOTES: MEASURING POINT ELEVATIONS MAY CHANGE; REFER TO CURRENT ELEVATION TABLE

CHEMICAL ANALYSIS



OVERBURDEN LOG 038443-62-03 SOIL GAS PROBES JULY 2013 GPJ CRA CORP GDT 9/18/13




STRATIGRAPHIC AND INSTRUMENTATION LOG (OVERBURDEN)

Page 1 of 1

PROJECT NAME: SOUTH DAYTON DUMP AND LANDFILL SITE
PROJECT NUMBER: 038443-62-03
CLIENT: PRP GROUP
LOCATION: MORaine, OH

HOLE DESIGNATION: GP24-13
DATE COMPLETED: July 3, 2013
DRILLING METHOD: GEOPROBE
FIELD PERSONNEL: J. CLOSE
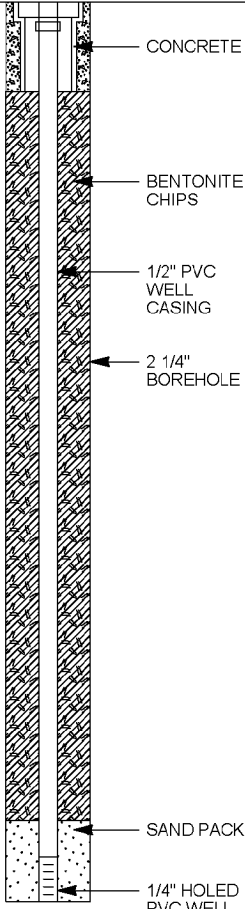
| DEPTH ft BGS | STRATIGRAPHIC DESCRIPTION & REMARKS | DEPTH ft BGS | SOIL GAS PROBE | SAMPLE | | | | |
|-----------------|---|-----------------|--|--------|----------|----------|-----------|-----------|
| | | | | NUMBER | INTERVAL | REC (ft) | 'N' VALUE | PID (ppm) |
| 2 | SP-SAND, trace silt, loose, little fine gravel, fine grained, poorly graded, brown, dry - silt at 1.3ft BGS | 1.40 |  <p>CONCRETE</p> <p>BENTONITE CHIPS</p> <p>1/2" PVC WELL CASING</p> <p>2 1/4" BOREHOLE</p> <p>SAND PACK</p> <p>1/4" HOLED PVC WELL SCREEN</p> | 1GP | | 4.0 | | 0.0 |
| 4 | SW-SAND, loose, medium to coarse sand, well graded, gray black - red clay brick at 1.7ft BGS | 2.00 | | | | | | 0.0 |
| 6 | SP-SAND, slightly compact, fine grained, poorly graded, gray - perched water zone at 4.5ft BGS | | | | | | | 0.0 |
| 8 | CL-SILTY CLAY, trace coarse sand and fine gravel, cohesive, low plasticity, brown, dry | 7.00 | | 2GP | | 4.5 | | 2.5 |
| 10 | SP-SAND, slightly compact, fine grained, poorly graded, gray - coarse sand, yellow/black at 8.9ft BGS - silty sand at 9.5ft BGS | 7.80 | | | | | | 0.0 |
| 12 | | | | | | | | 0.0 |
| 14 | | | | 3GP | | 0.7 | | 0.0 |
| 16 | ML-CLAYEY SILT, brown, moist | 15.00 | | | | | | 0.0 |
| 18 | SW/GW-SAND/GRAVEL, loose, well graded, brown/tan, dry | 16.00 | | 4GP | | 2.5 | | 0.0 |
| 20 | END OF BOREHOLE @ 20.0ft BGS | 20.00 | | | | | | 0.0 |
| 22 | | | <p>WELL DETAILS Screened interval: 19.00 to 20.00ft BGS Length: 1ft Diameter: 0.5in Slot Size: 0.25 Material: PVC Seal: 2.00 to 18.20ft BGS Material: BENTONITE CHIPS Sand Pack: 19.00 to 20.00ft BGS Material: #3 SAND</p> | | | | | |

NOTES: MEASURING POINT ELEVATIONS MAY CHANGE; REFER TO CURRENT ELEVATION TABLE

CHEMICAL ANALYSIS



OVERBURDEN LOG 038443-62-03 SOIL GAS PROBES JULY 2013.GPJ CRA_CORP.GDT 9/18/13